


T.7S.R.3W.W.M.

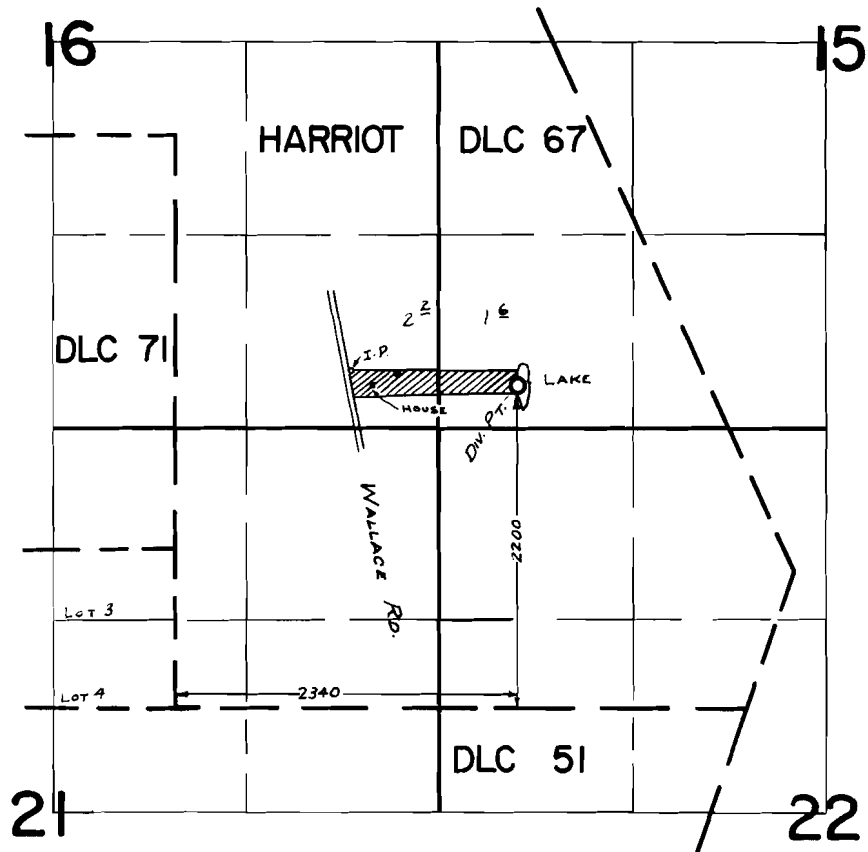

FINAL PROOF SURVEY
UNDER

Application No. 45190 Permit No. 3376/
IN NAME OF

FRANK N. GRIMM

Surveyed SEPT. 4, 1969, by D. BUELL