



PERMIT #22983 SUPPLEMENTAL



PERMIT #22983 PRIMARY

13

R-1635
P 22983
P 22984

FINAL PROOF SURVEY

UNDER

APPLICATION NOS. 29144 PERMIT NOS. 22983

R-29146

R-1635

29147


22984

IN NAME OF


CLINTON O. and FLORA H. HARRIS

SURVEYED JUNE 7, 1968 BY V. GARNER

27

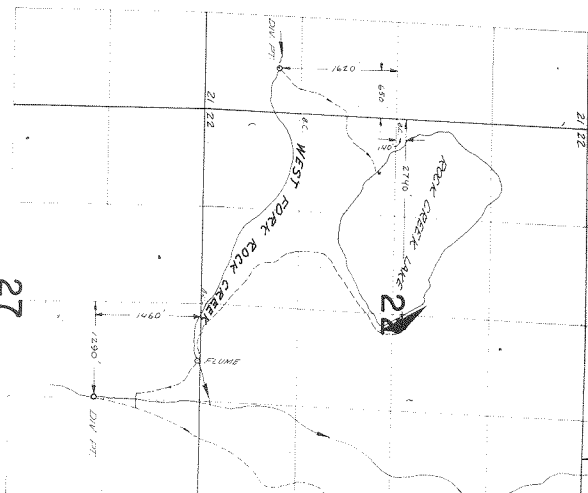

23

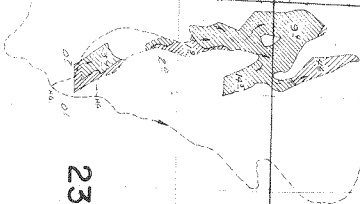

CL


R-1635

21 22

15

10



14

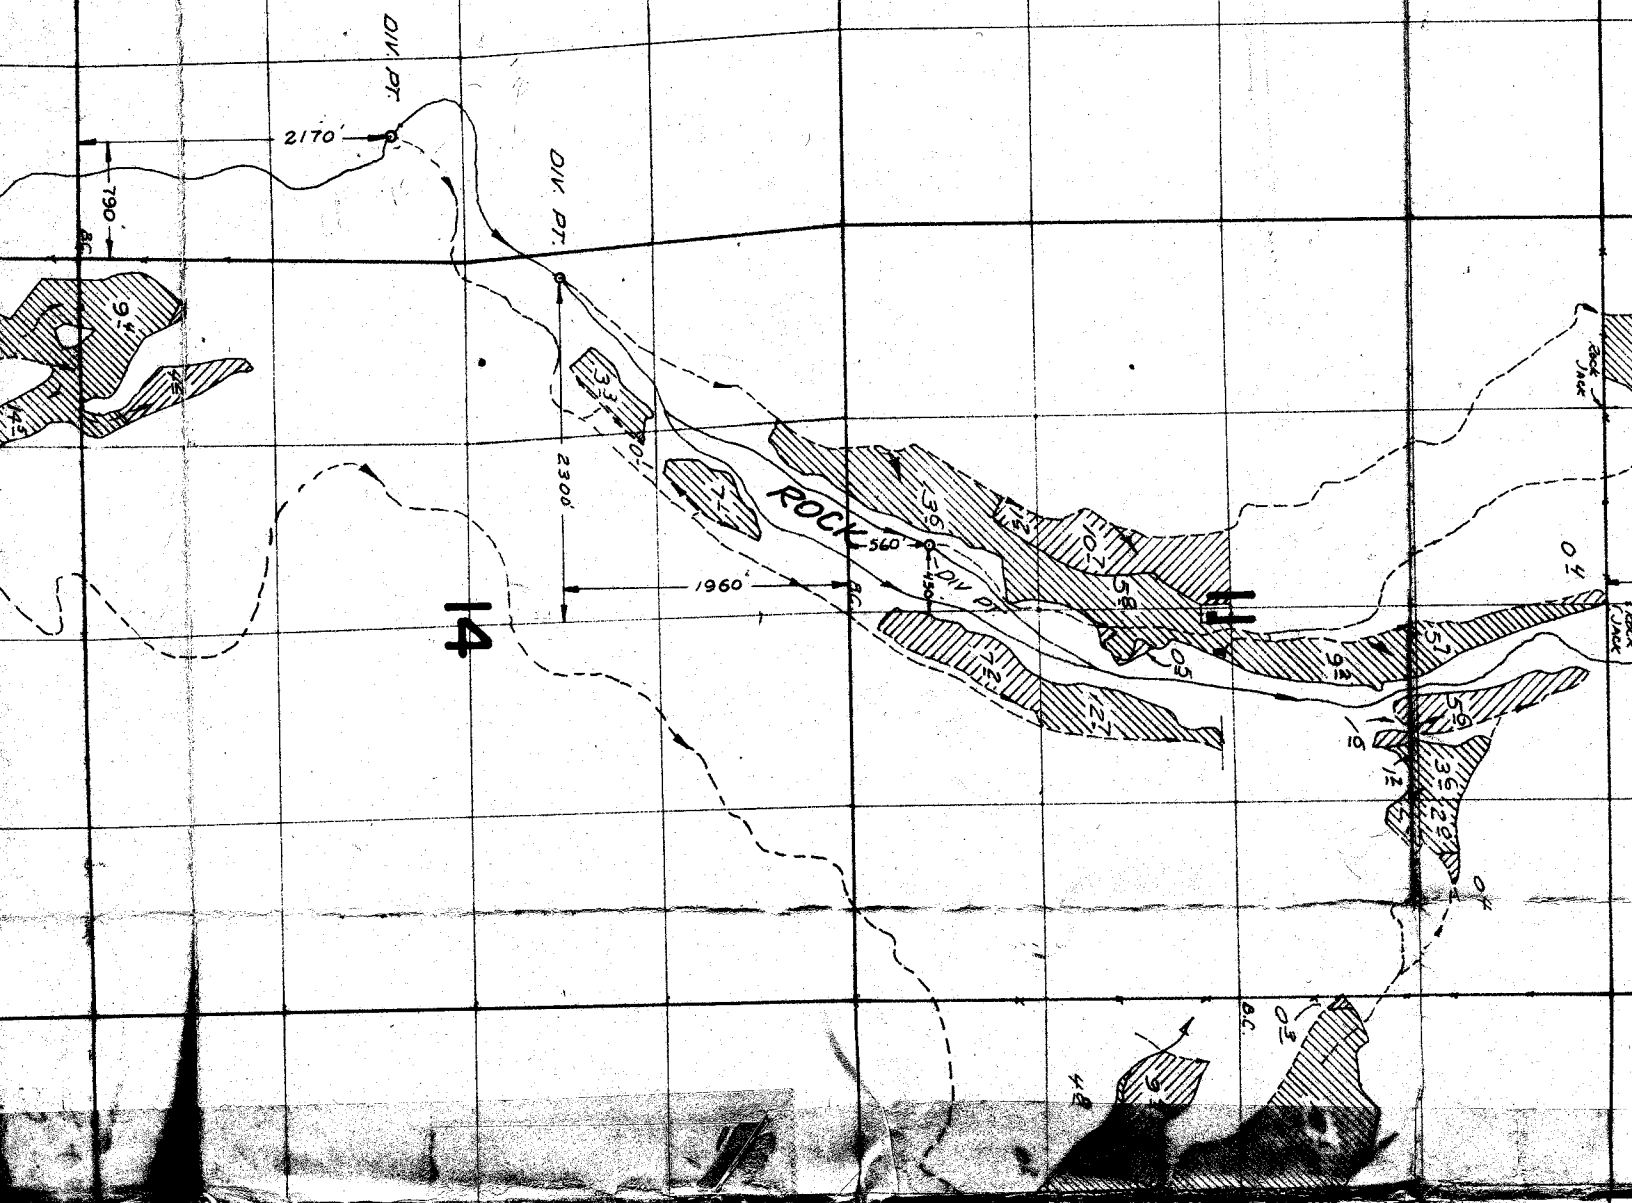



1125
1135

T.12&13S. R.24&25E. W.M.

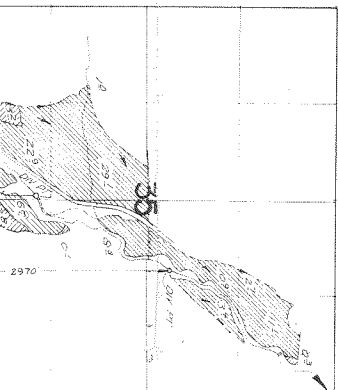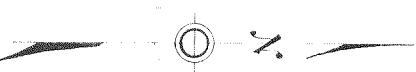

ROCK CREEK

25

30

REEK

36

31

3.

497 3	497 2		497
-------	-------	--	-----

4 of 2

R.24E.
R.25E.

6

R 24 E.
R 25 E.

6

12



PERMIT #22383 SUPPLEMENTAL



PERMIT #22383 PRIMARY

13

1635
2983
2984