



PERMIT #22983 SUPPLEMENTAL



PERMIT #22983 PRIMARY

13

R-1635
P-22983
P-22984

FINAL PROOF SURVEY

UNDER

APPLICATION NOS. 29144 PERMIT NOS. 22983

R-29146

R-1635



29147

22984

IN NAME OF

CLINTON O. and FLORA H. HARRIS

SURVEYED JUNE 7, 1968 BY V. GARNER

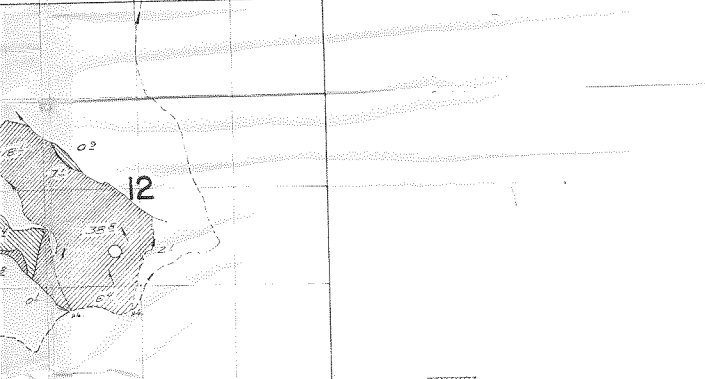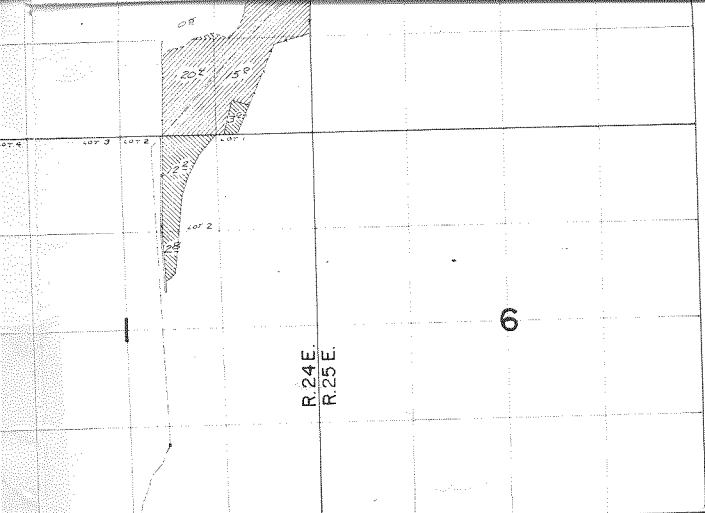

PERMIT #22983 SUPPLEMENTAL




PERMIT #22983 PRIMARY

25

30


36

31

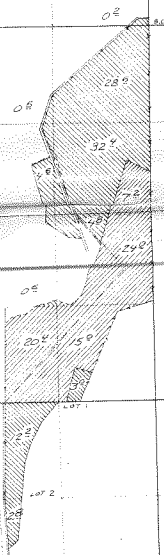

6

T.12 & 13S. R.24 & 25E. W.M.

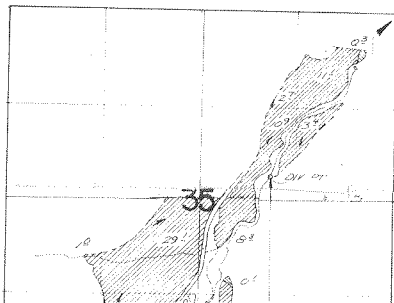

ROCK CREEK

