


T.12 & 13S. R.24 & 25E. W.M.

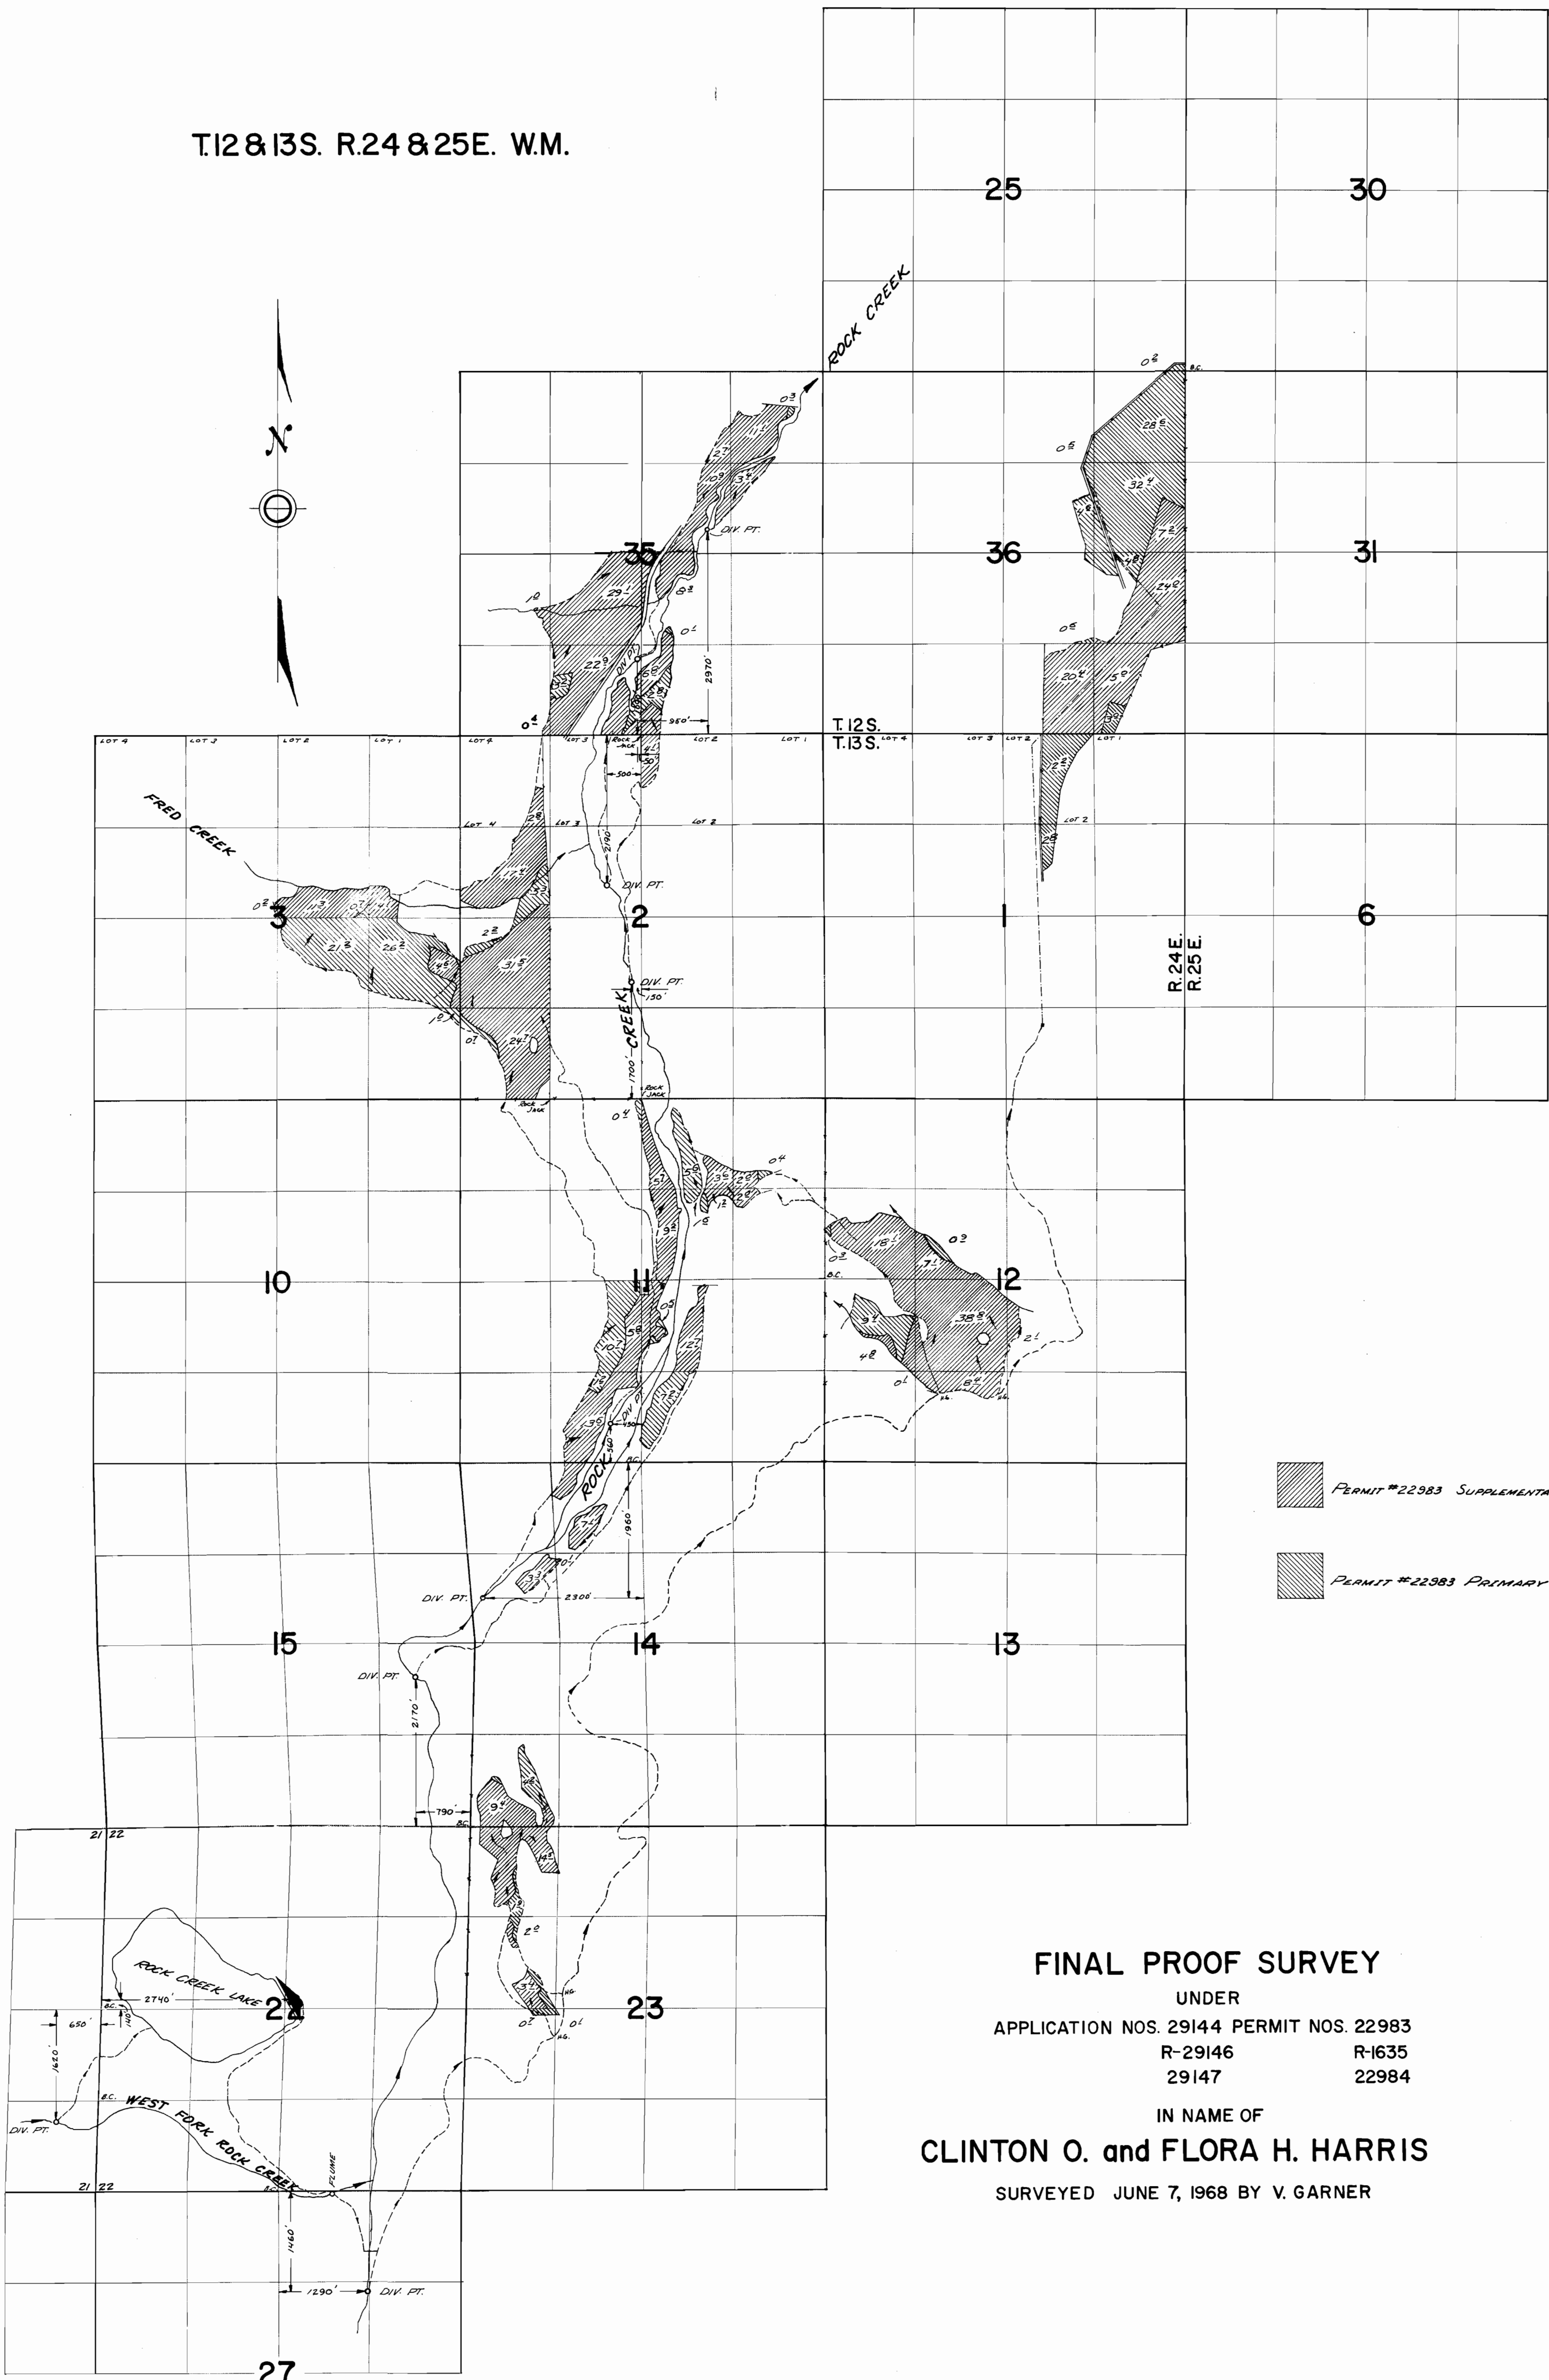

FINAL PROOF SURVEY

UNDER
APPLICATION NOS. 29144 PERMIT NOS. 22983
R-29146 R-1635
29147 22984

IN NAME OF
CLINTON O. and FLORA H. HARRIS
SURVEYED JUNE 7, 1968 BY V. GARNER