


# T.30S.R.11W.W.M.

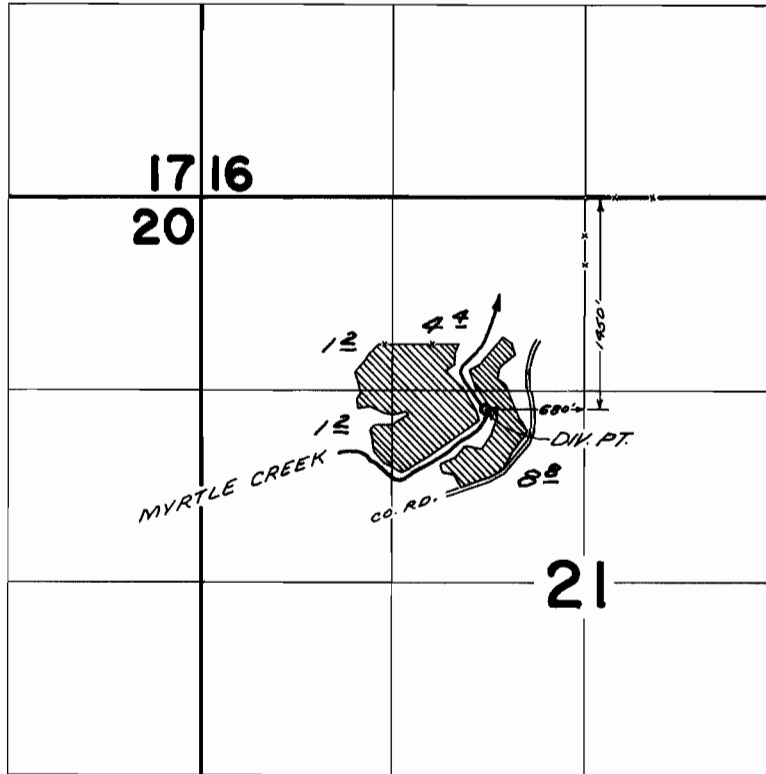

## FINAL PROOF SURVEY UNDER

Application No. 38626 Permit No. 28755  
IN NAME OF

JAMES L. GILL

Surveyed AUG. 22 1969, by D. BUELL