


T. 29 & 30 S. R. 12 W. W.M.

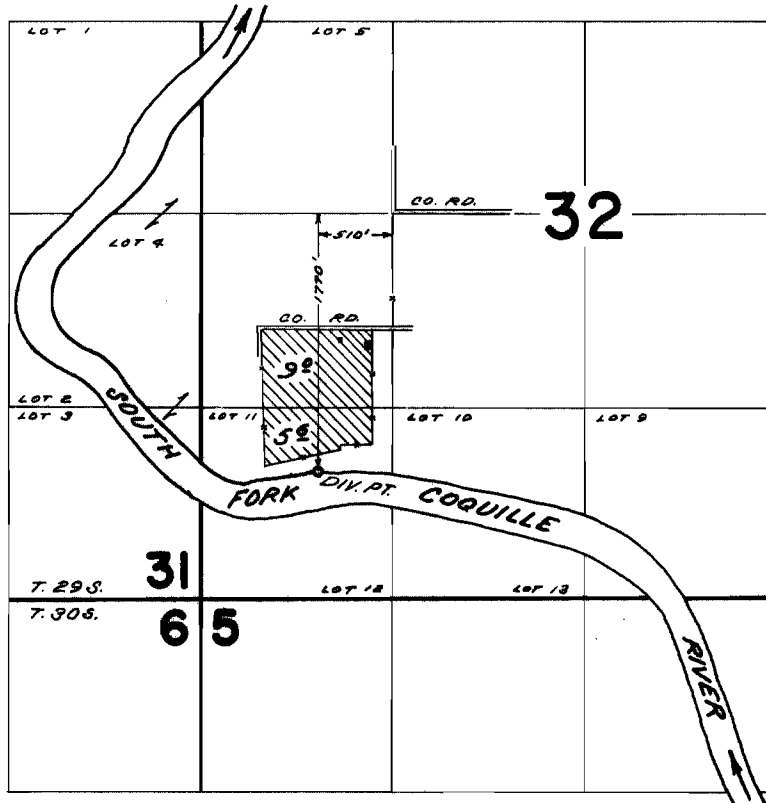

FINAL PROOF SURVEY
UNDER

Application No. 39661 Permit No. 29465
IN NAME OF

DALE L. HOFFMAN

Surveyed SEP 16 1969, by D. BUELL