


T.30S.R.12W.W.M.

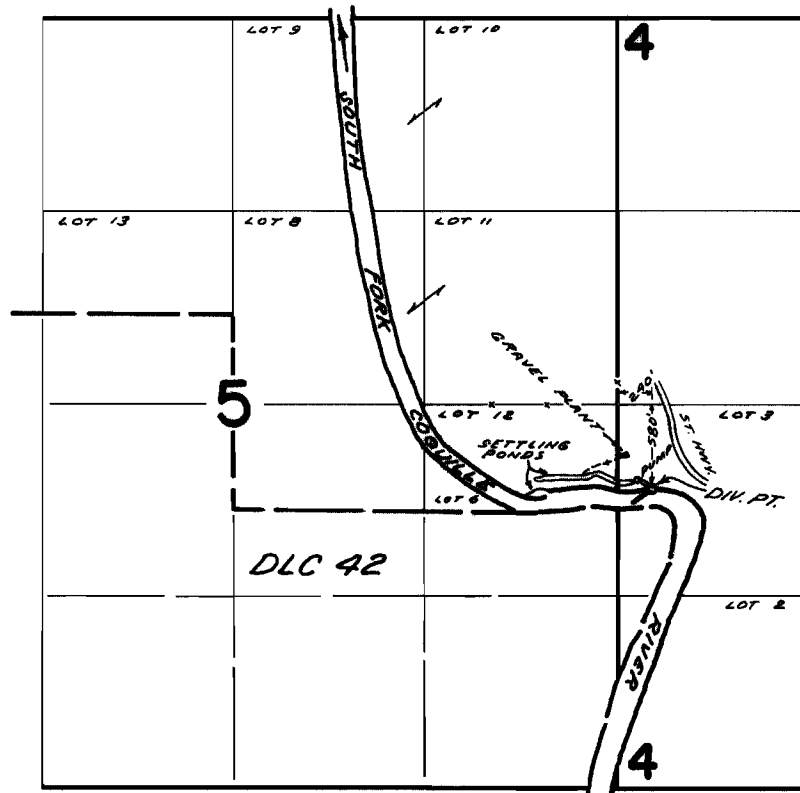

FINAL PROOF SURVEY
UNDER

Application No. 39716 Permit No. 29629
IN NAME OF

ELMER & DEAN BENHAM

Surveyed AUG 19 1969, by D. BUELL