


T.30S.R.11W.W.M

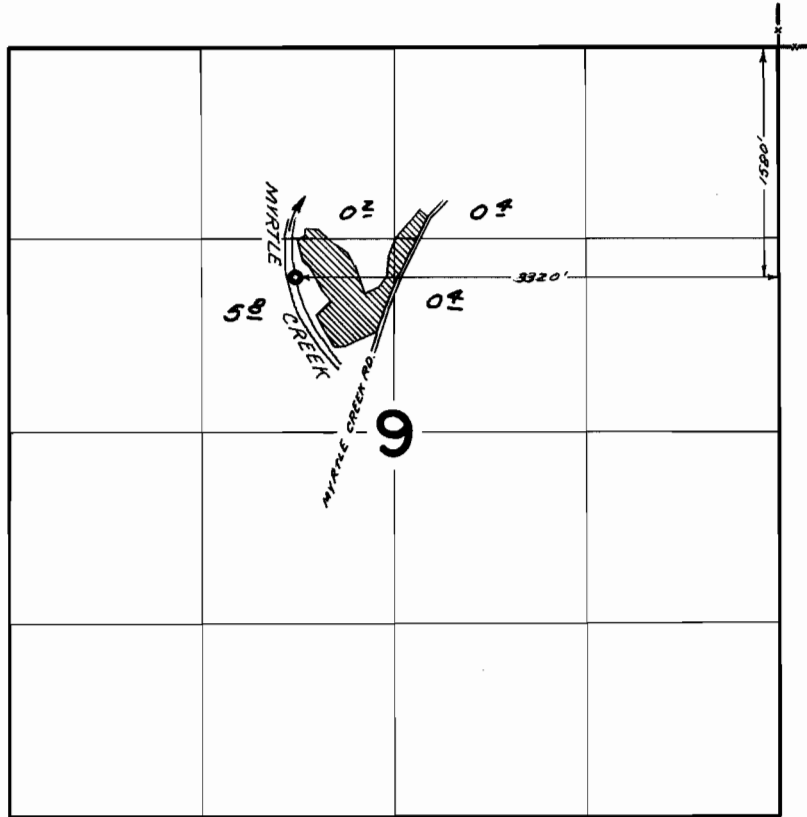

FINAL PROOF SURVEY UNDER

Application No. 41668 Permit No. 31095
IN NAME OF

CHURCH OF THE BRETHERN

Surveyed SEP 9 1969, by D. BUELL