


T.27S.R.6W.W.M.

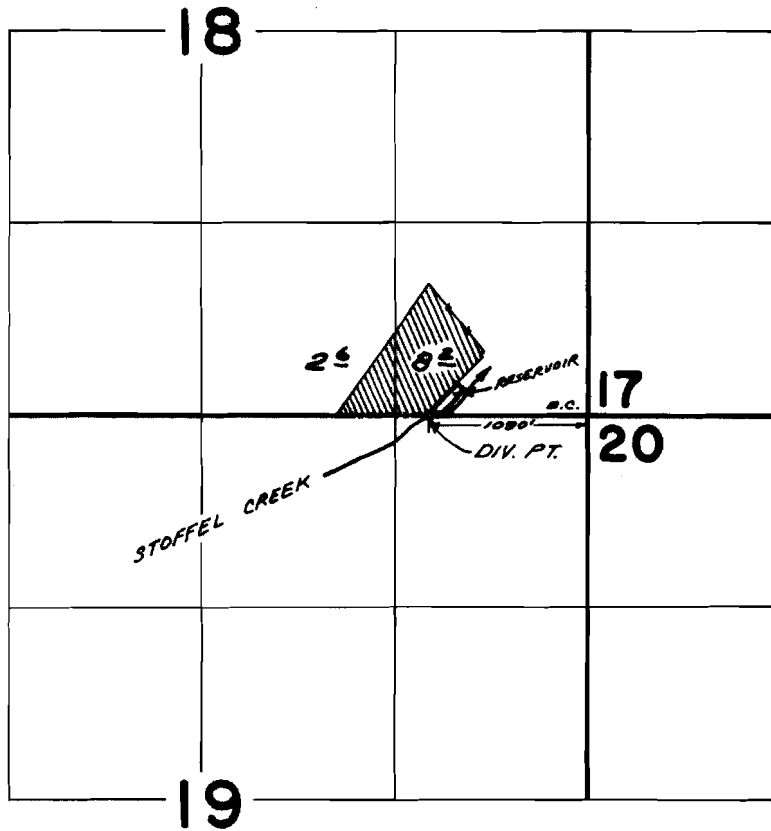

FINAL PROOF SURVEY
UNDER

Application No. R-41897 41898 Permit No. R-4772 31367
IN NAME OF

KENNETH E. RIEKE

Surveyed APR. 16 1969, by D. BULL