


T.27 S.R.6 W.W.M.

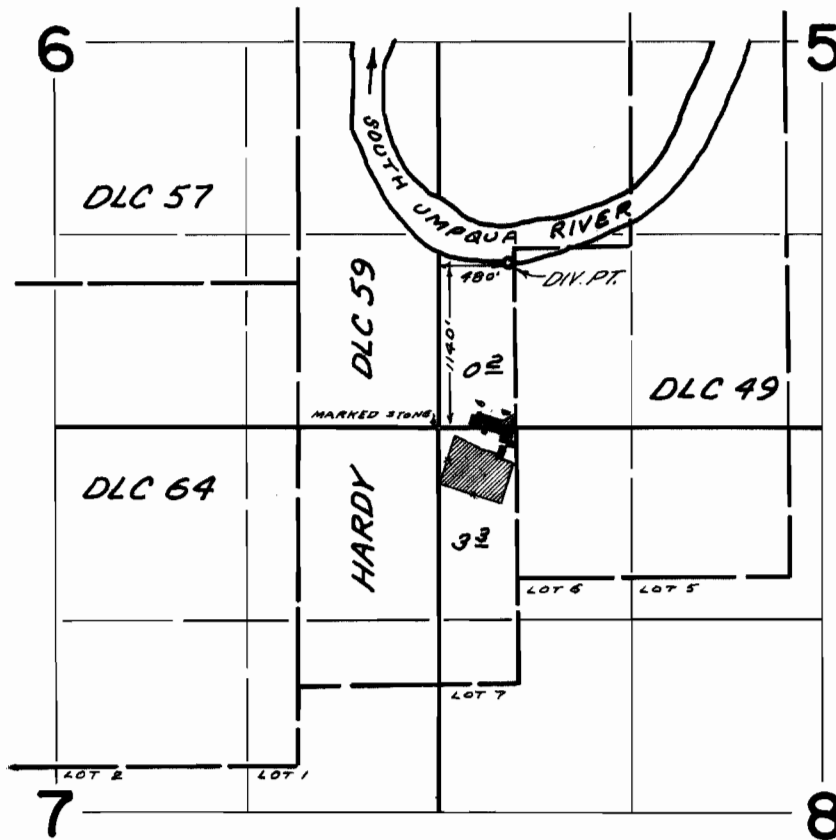

**FINAL PROOF SURVEY**  
UNDER

Application No. 37120 Permit No. 27660  
IN NAME OF

DOUGLAS COUNTY SCHOOL DIST. NO. 4

Surveyed APR. 15, 1969, by D. BUELL