


THREE HORN CAMPGROUND WATER SUPPLY

UMPQUA NATIONAL FOREST

Cow Creek District

T.32S., R.1W., W.M.

Scale 4" = 1 mi.

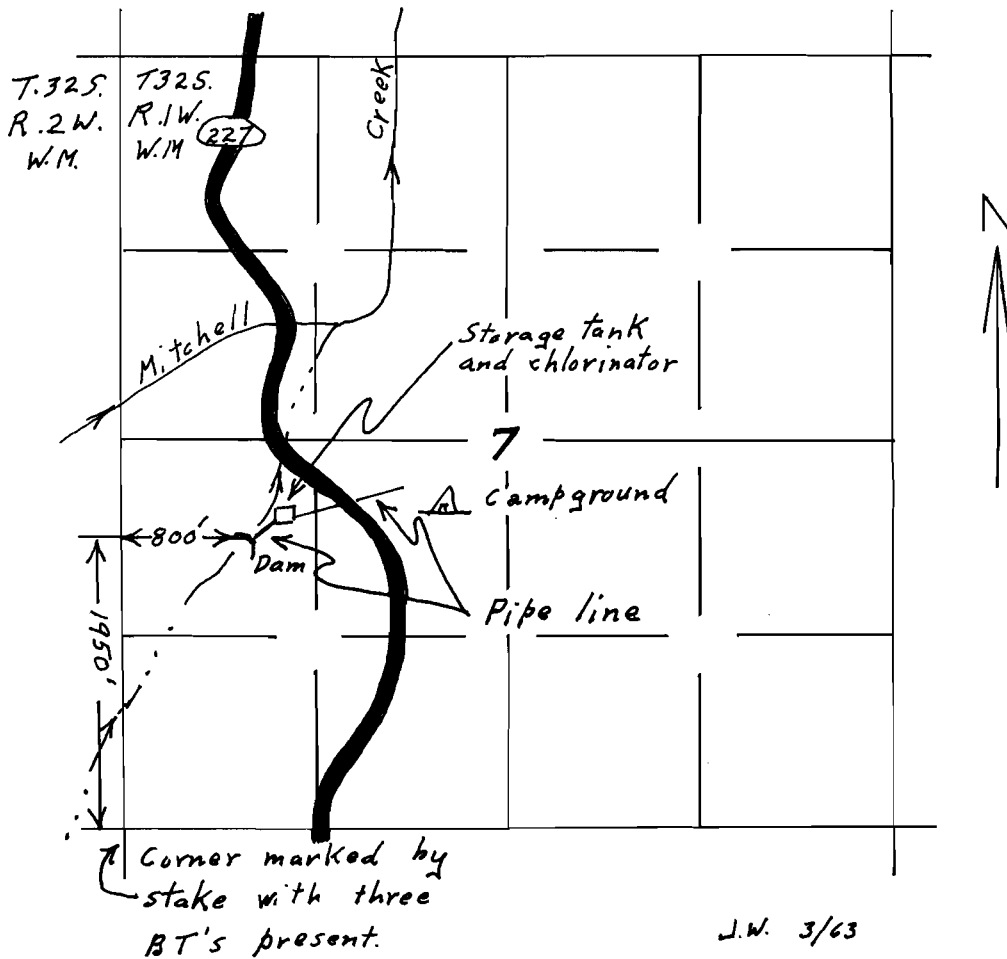

Application No. 38581

Permit No. 28742