


T.22S.R.4W.W.M.

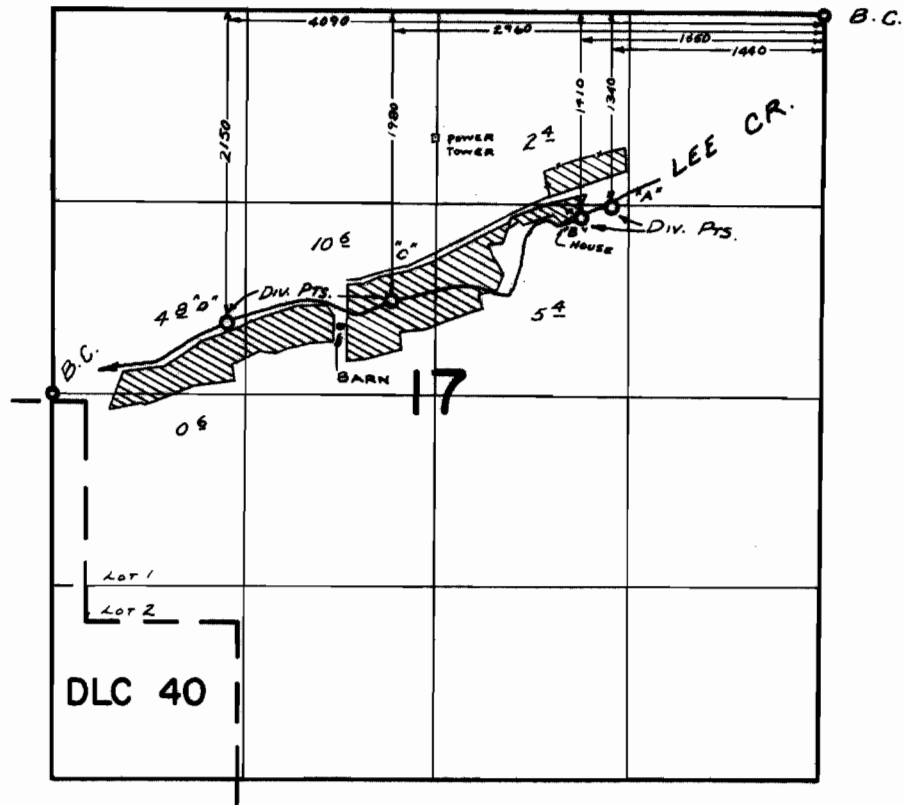

**FINAL PROOF SURVEY**  
UNDER

Application No. 39642 Permit No. 29522  
IN NAME OF

**MATILDA J. RUSSELL**

Surveyed JULY 9, 1969, by W. RUPPERT