


T.30&31S.R.5&6W.W.M.

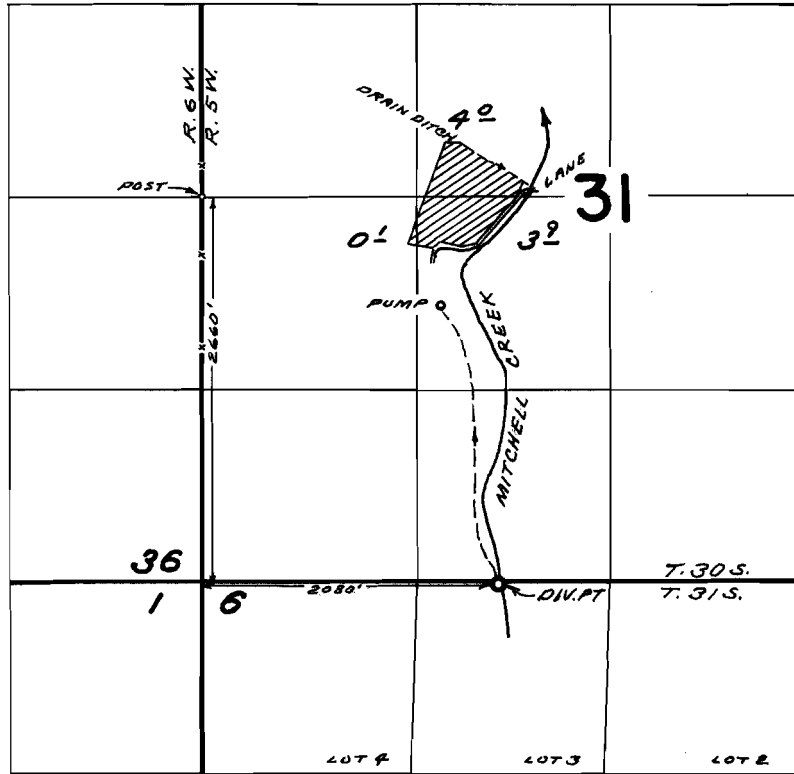

FINAL PROOF SURVEY UNDER

Application No. 39972 Permit No. 29742
IN NAME OF

IRA A. AND LURA D. SUTTON

Surveyed JUN 24 1969 by D. BUELL