


T.27S.R.3W.W.M.

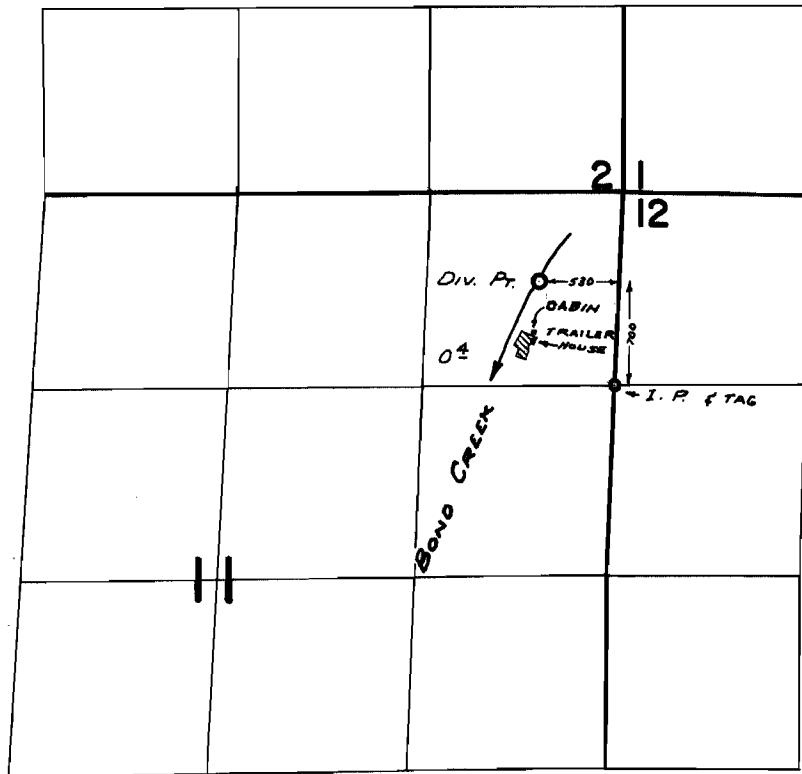

FINAL PROOF SURVEY
UNDER

Application No. 39209 Permit No. 29825
IN NAME OF

JAY M. CHANDLER, JR.

Surveyed APR. 14, 1969, by W. RUPPERT