


T. 25 S. R. 5 W. W.M.

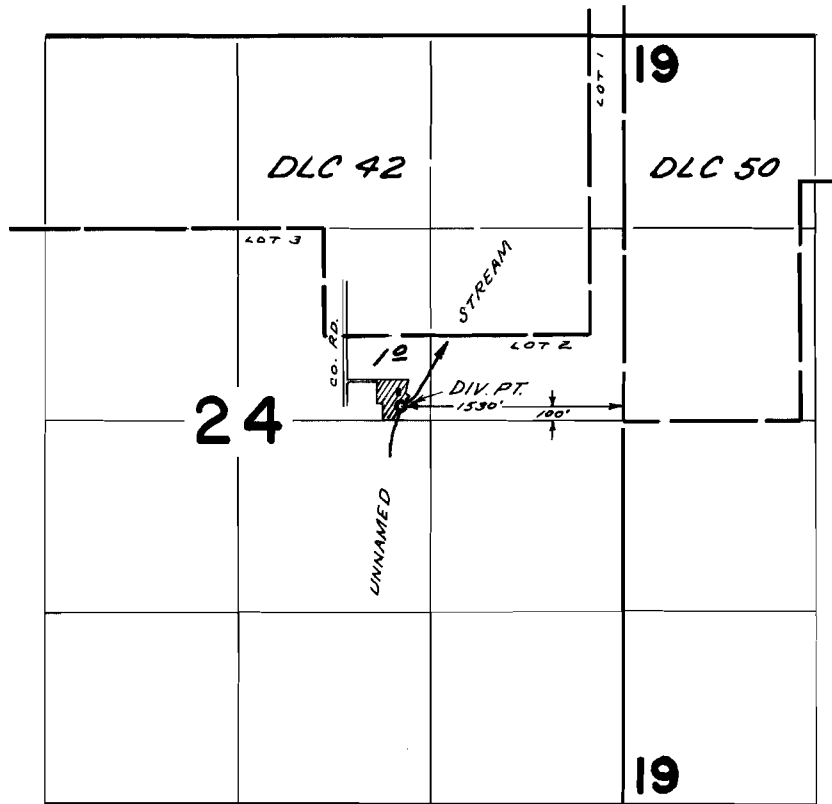

FINAL PROOF SURVEY  
UNDER

Application No. 40124 Permit No. 29912  
IN NAME OF

ESTATE OF BEN JONES

Surveyed APR. 17 1969, by D. BUELL