


T.27&28S.R.7W.W.M.

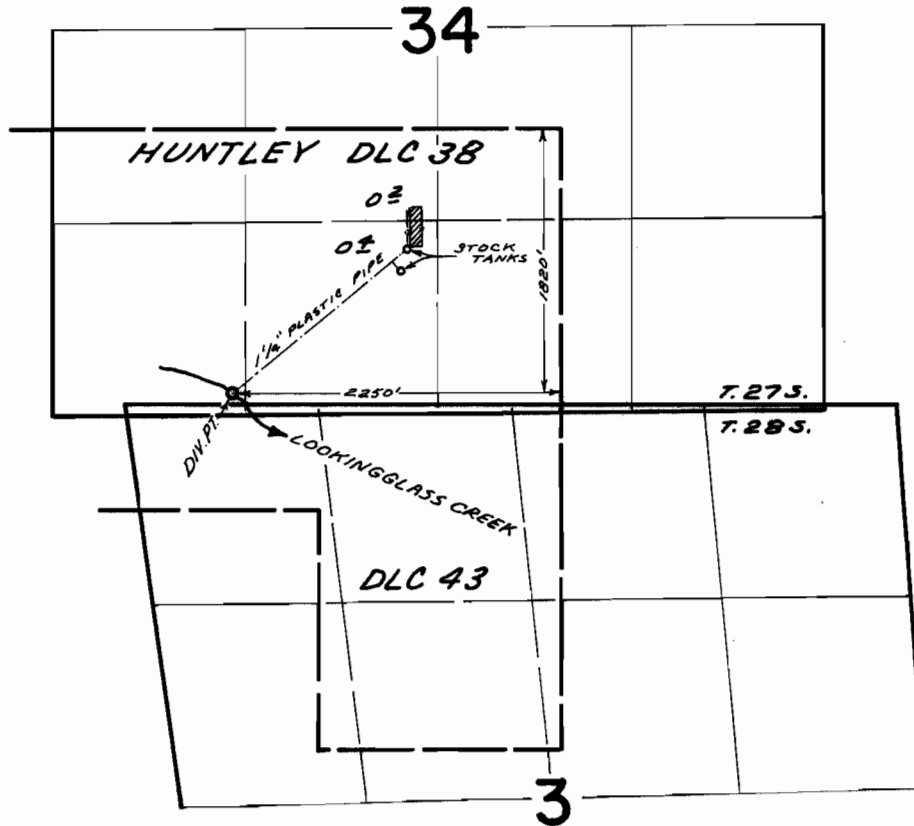

FINAL PROOF SURVEY
UNDER

Application No. 40433 Permit No. 30140
IN NAME OF

NEAL MEYER SR.

Surveyed APR 16 1969, by D. BUELL