


T. 32 S. R. 5 W. W. M.

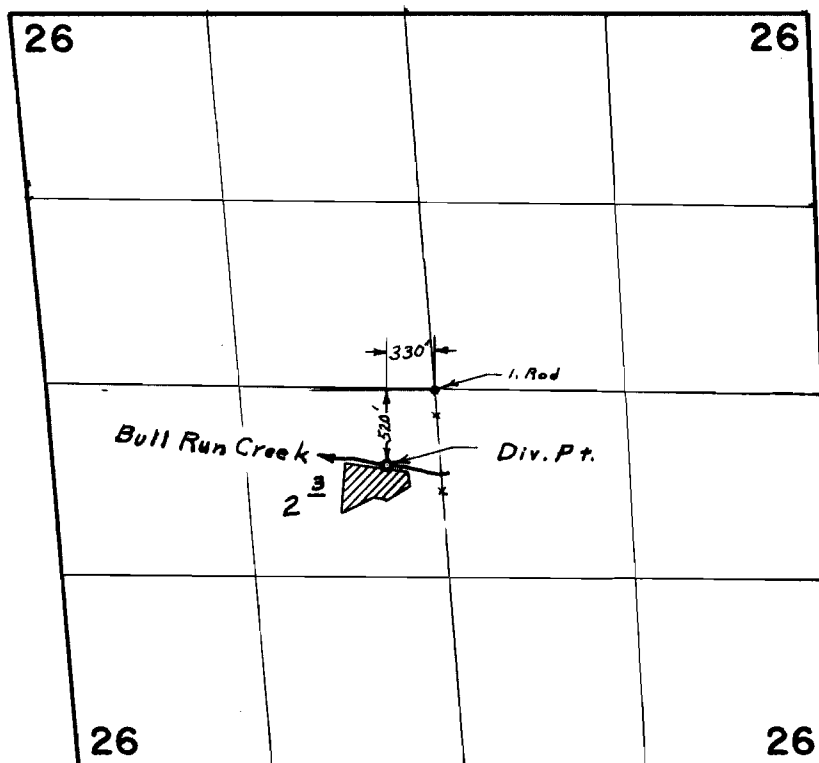

FINAL PROOF SURVEY
UNDER

Application No. 42053 Permit No. 31477
IN NAME OF

PAUL JOHN STAACK

Surveyed July 28, 1969, by L. E. Gould