


T.27S.R.6W.W.M.

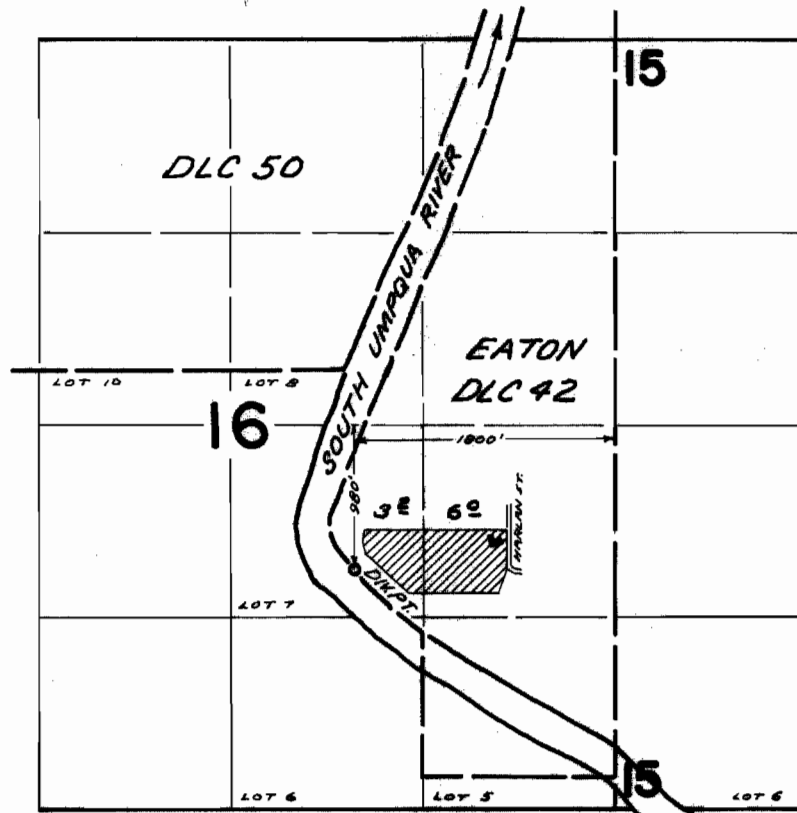

FINAL PROOF SURVEY UNDER

Application No. 43632 Permit No. 32620
IN NAME OF

GERALD L. CASEBOLT

Surveyed APR. 18 1969, by D. BUELL