


T.27S.R.6W.W.M.

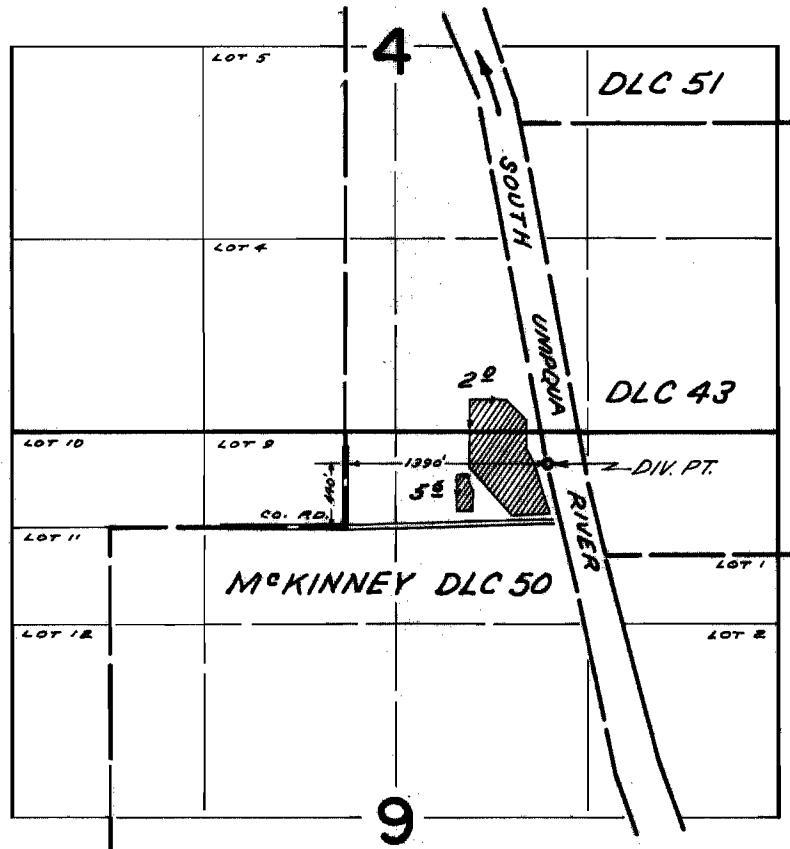

**FINAL PROOF SURVEY**  
UNDER

Application No. 43634 Permit No. 32622  
IN NAME OF

ROBERT TJOMSLAND

Surveyed APR. 18 1969, by D. BUELL