


T. 30S. R. 18 & 2 W. W.M.

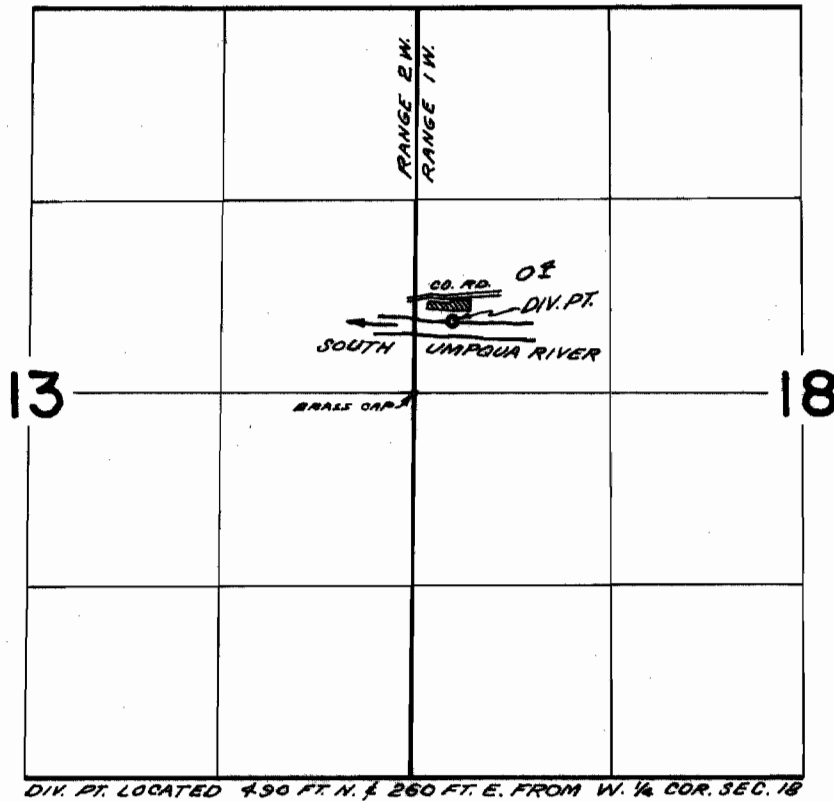

FINAL PROOF SURVEY
UNDER

Application No. 44948 Permit No. 33597
IN NAME OF

B. M. WOOLSEY

Surveyed JUL. 30 1969, by D. BUELL