T.29S.R.6W.W.M.

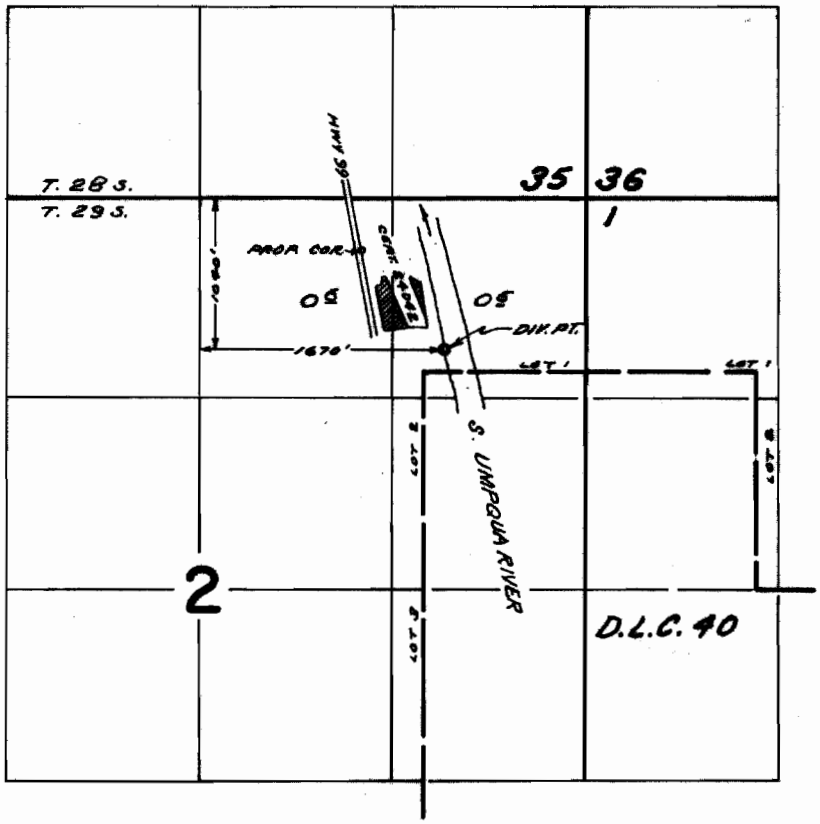

FINAL PROOF SURVEY
UNDER

Application No. 45012 Permit No. 33637
IN NAME OF

HERBER L. SPANGLER

Surveyed JUN. 27 1969, by D. BUELL