


T. 40 S. R. 3 W. W. M.

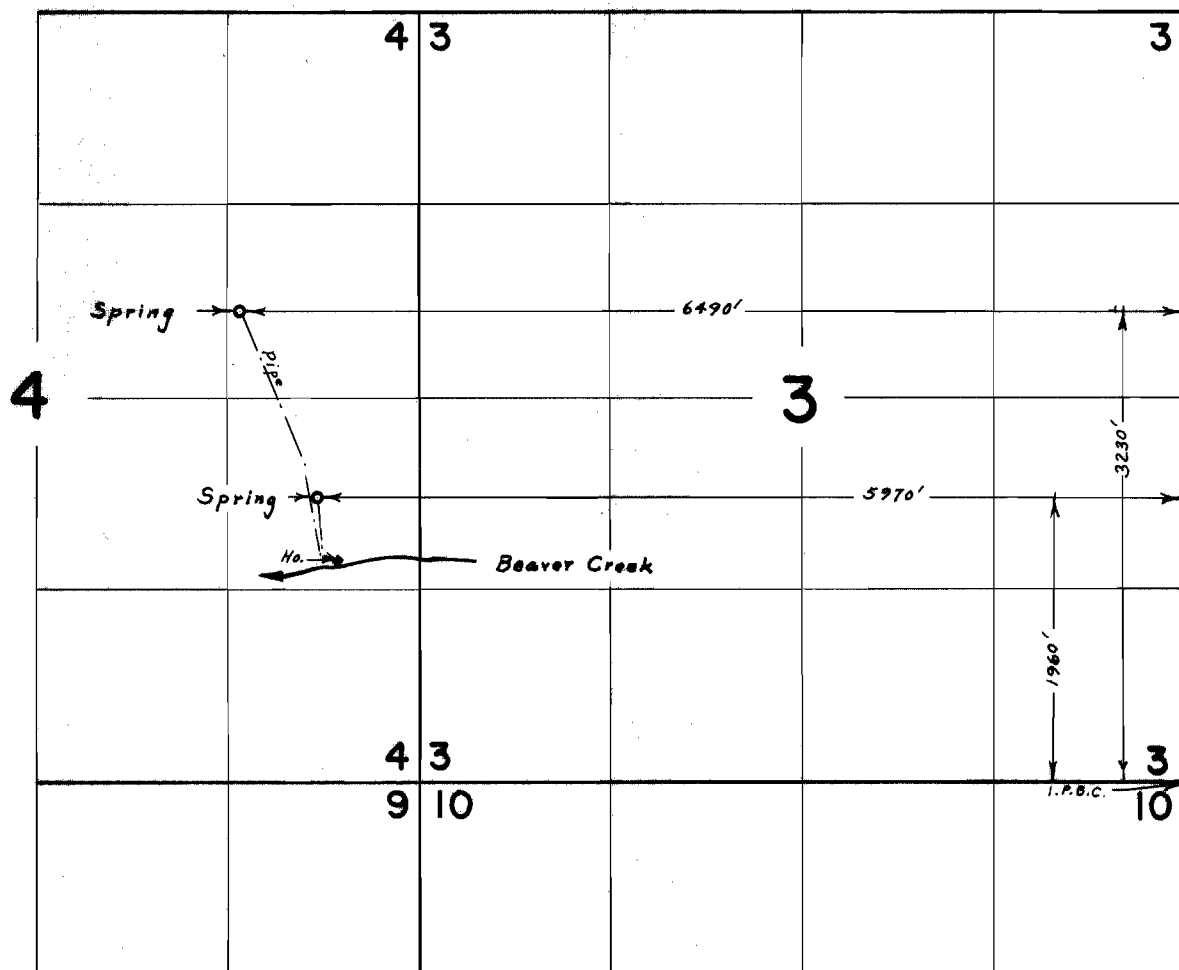

FINAL PROOF SURVEY UNDER

Application No. 35098 Permit No. 27459
IN NAME OF

GILBERT &/OR RUBY MUNDEN

Surveyed June 11, 1969, by L. E. Gould