


T. 36 S. R. 2 W. W. M.

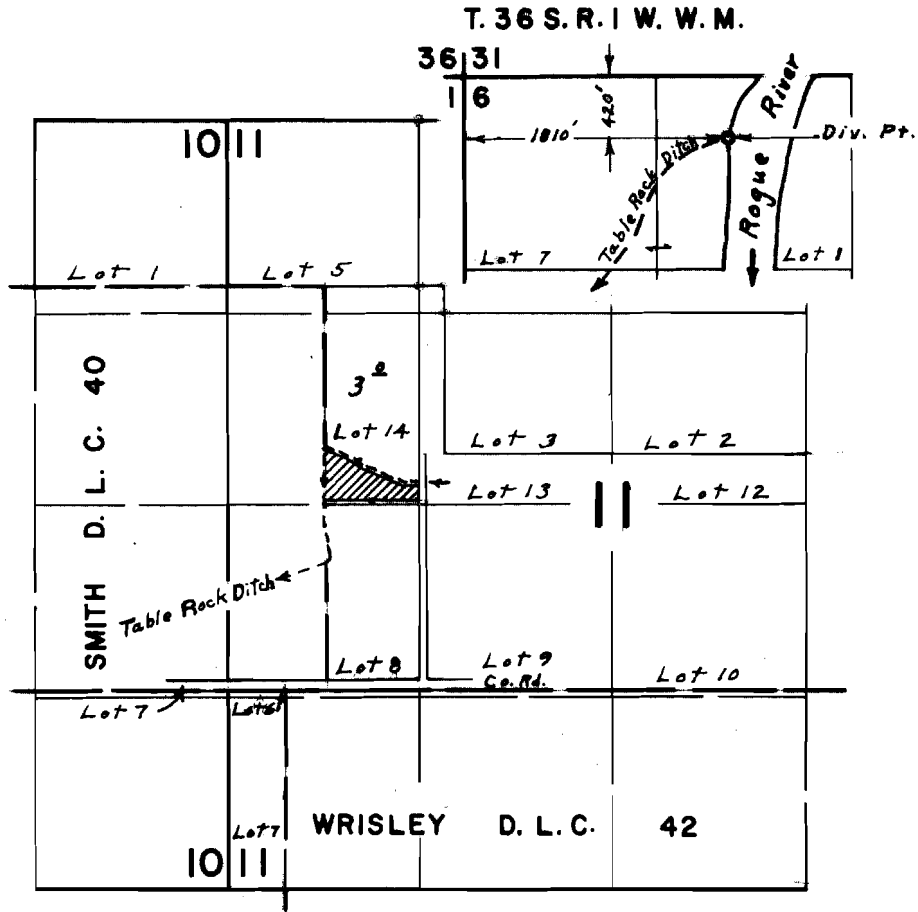

FINAL PROOF SURVEY UNDER

Application No. 40866 Permit No. 30465

IN NAME OF
E. C. HAMILTON ESTATE
BY EVELYN SKYRMAN

Surveyed June 3, 1969, by L. E. Gould