


T.38S.R.7W.W.M.

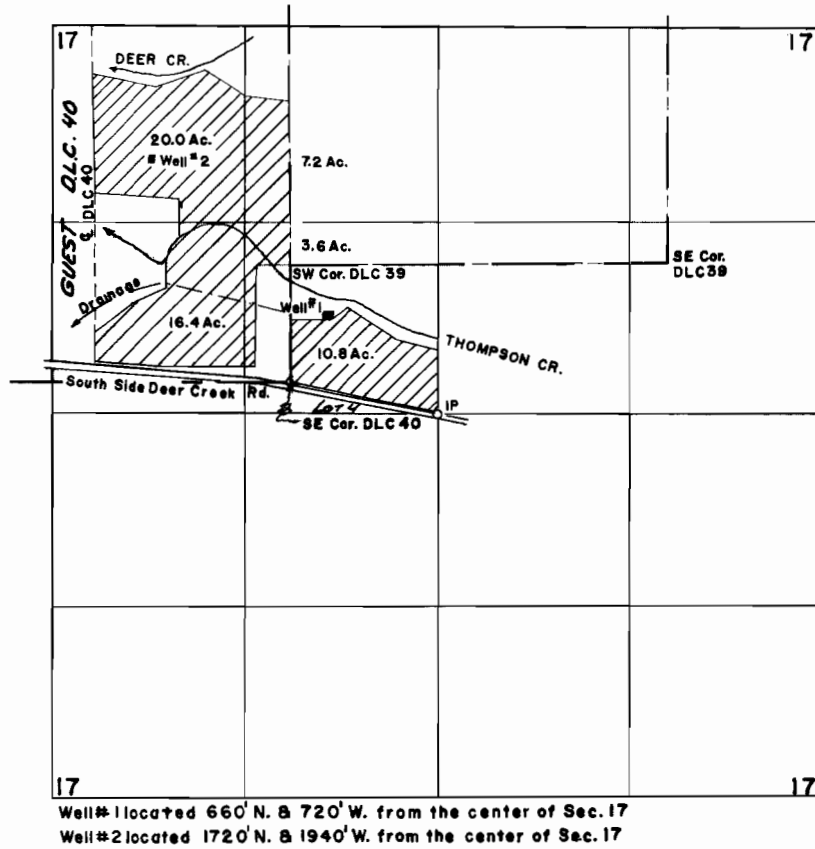

FINAL PROOF SURVEY UNDER

Application No. G-2750... Permit No. G-2555...
IN NAME OF

E. N. LIPPERT

Surveyed Sept. 27, 1968., by R. B. Steimer.....