


T. 37 S. R. 5 W. W.M.

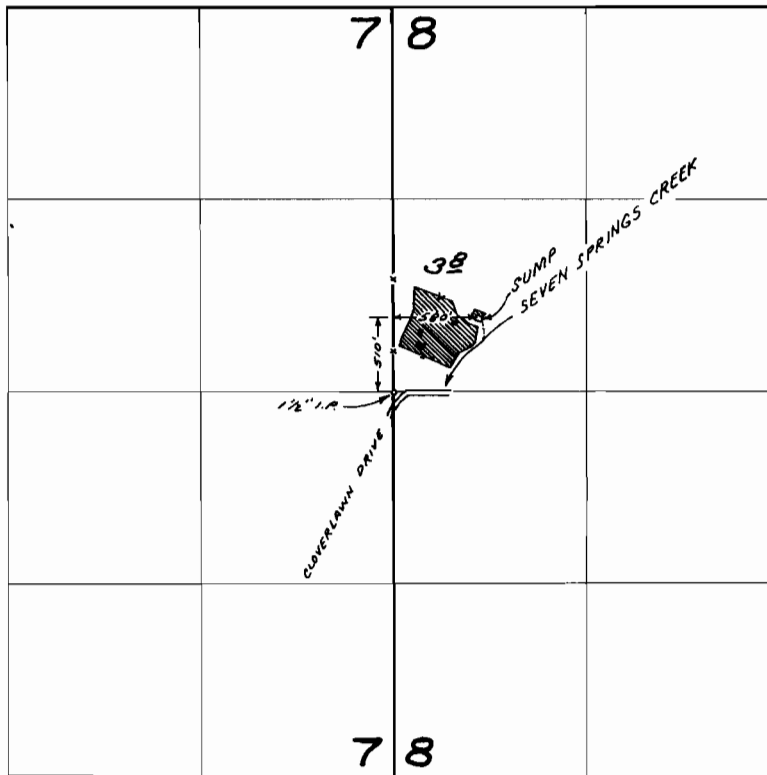

FINAL PROOF SURVEY
UNDER

Application No. G-3268 Permit No. G-3064
IN NAME OF

CHARLES V. REED

Surveyed JUN. 12 1969, by D. BUELL