


T. 37 S. R. 5 W. W.M.

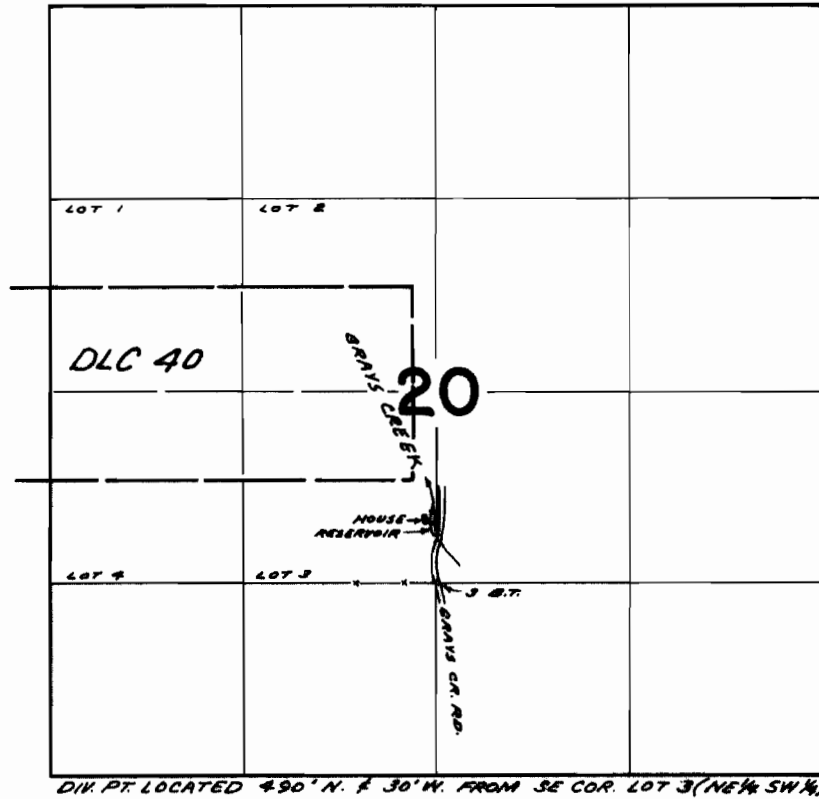

FINAL PROOF SURVEY UNDER

Application No. R-41417 41707 Permit No. R-4893 32153
IN NAME OF

WILLIAM P. KEEN

Surveyed JUN 3 1969, by D. BUELL