


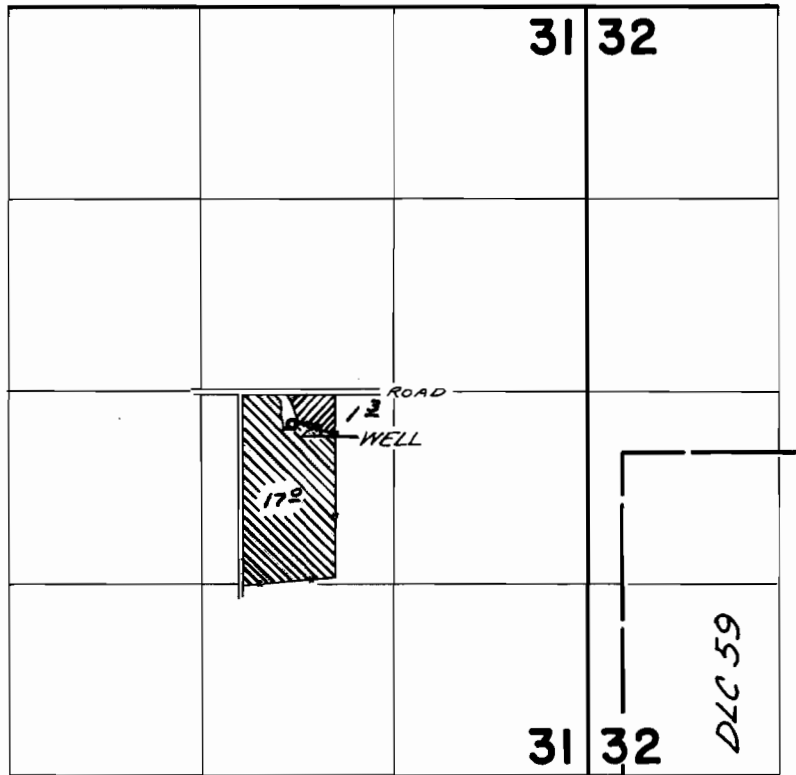

T.16S.R3W.W.M.



WELL LOCATED 230' S. & 620' E FROM CENTER SEC 31

 Cert. GR-1082  PERMIT G3229

**FINAL PROOF SURVEY**  
UNDER

Application No. G-3449 Permit No. G-3229  
IN NAME OF

BOB D. DOWNING

Surveyed APR. 29 1969, by D. BUELL