


T.17 S.R.5 W.W.M.

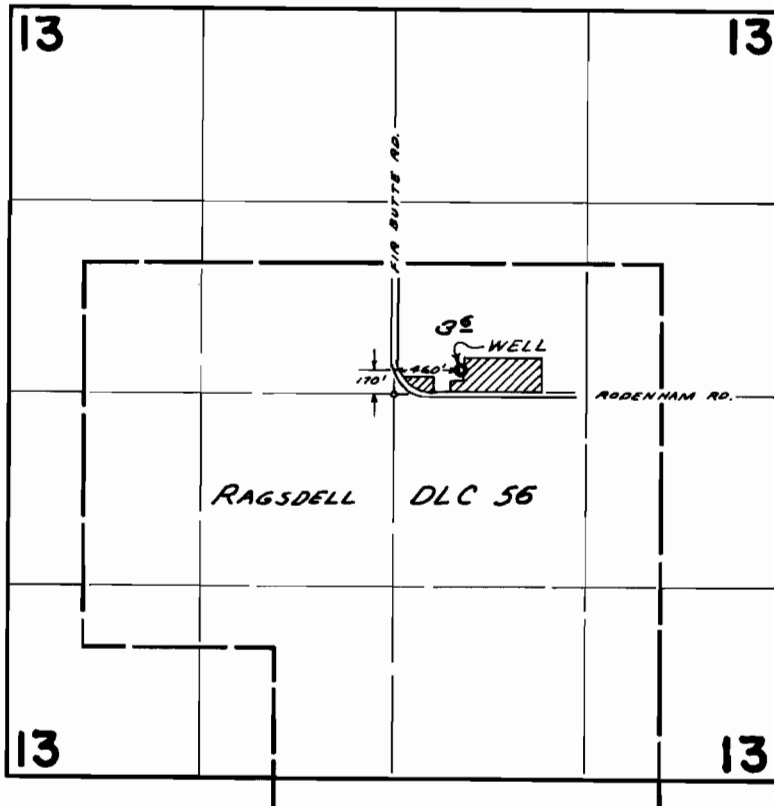

FINAL PROOF SURVEY
UNDER

Application No. G-3654 Permit No. G-3433
IN NAME OF

CLYDE JOHNSON

Surveyed MAY 27 1969, by D. BUELL