


T.17 S.R.10 W.W.M.

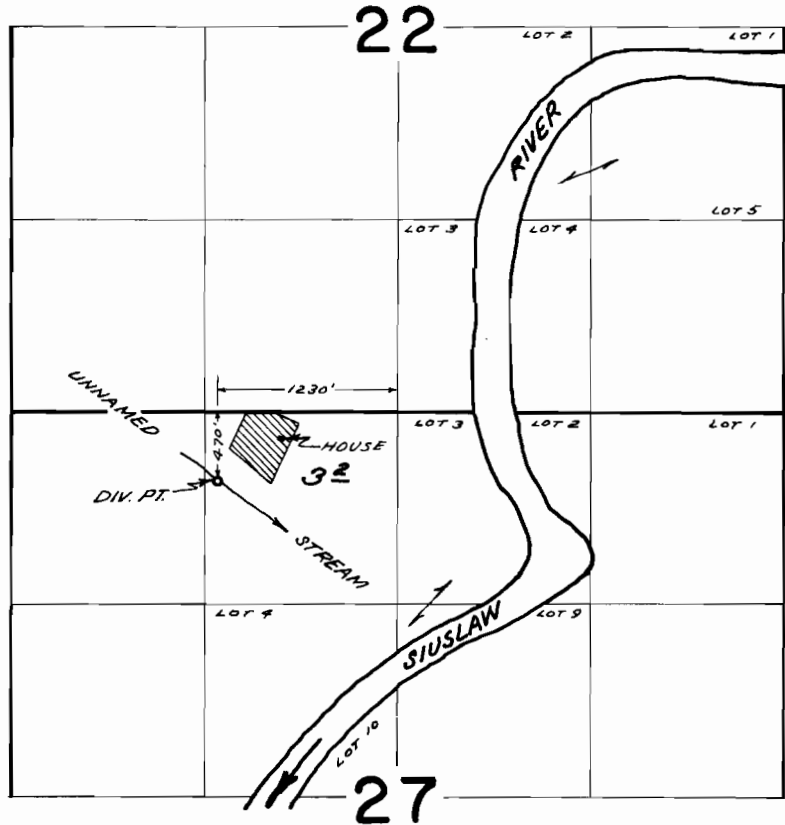

**FINAL PROOF SURVEY**  
UNDER

Application No. 39822 Permit No. 29592  
IN NAME OF

VERNON L. & CAROL J. VAN CURLER

Surveyed AUG. 7, 1969, by D. BUELL