


T.17 S. R. 12 W. W.M.

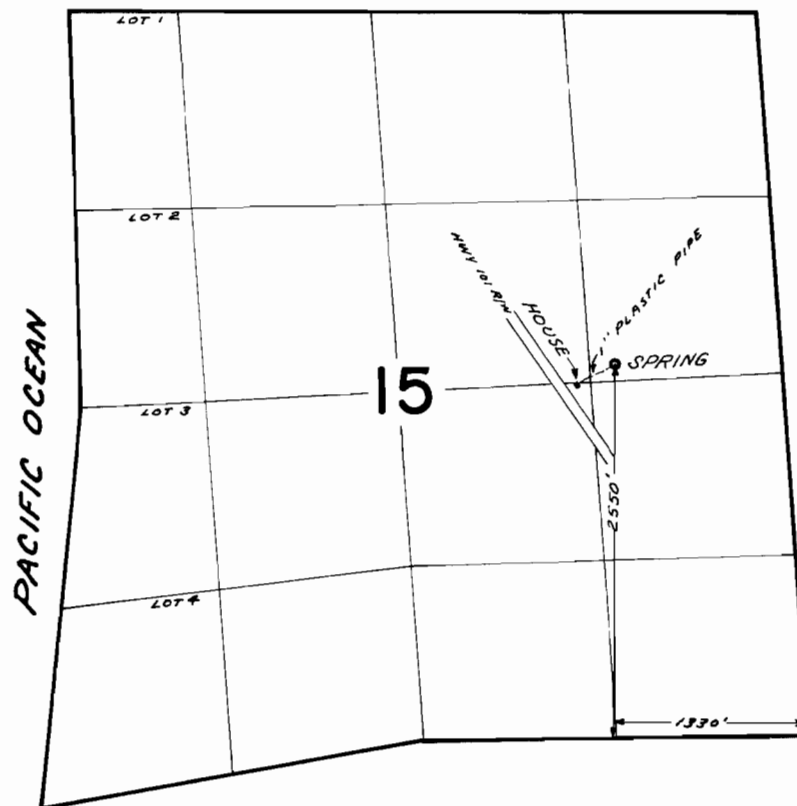

FINAL PROOF SURVEY
UNDER

Application No. 41458 Permit No. 30736
IN NAME OF

C. IVAN & EILEEN G. BRANTON

Surveyed AUG. 4 1969, by D. BUELL