


T. 16 S. R. 6 W. W. M.

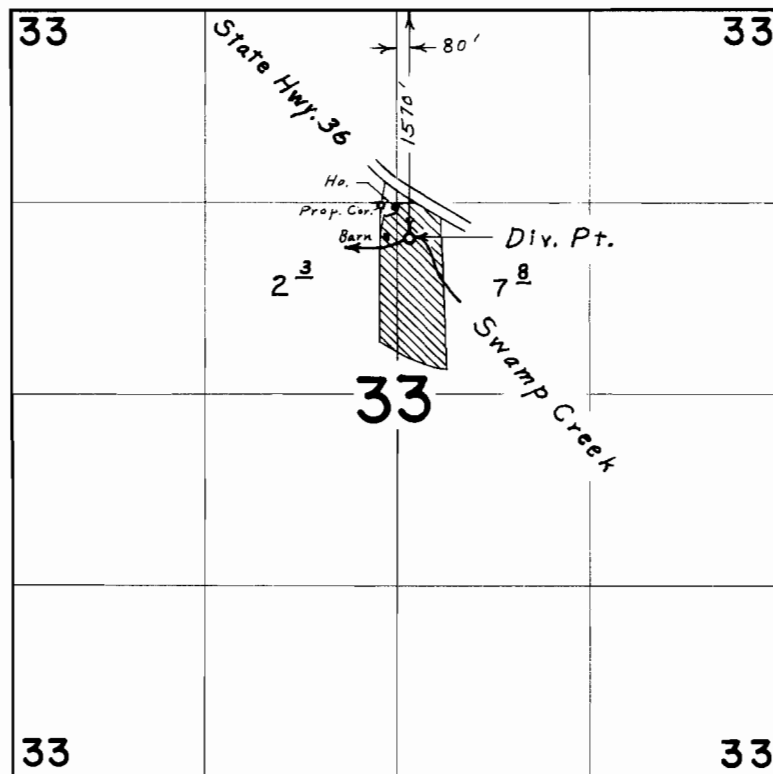

FINAL PROOF SURVEY
UNDER

Application No. 42354 Permit No. 31211
IN NAME OF

WAYNE H. CRABTREE

Surveyed April 18, 1969, by L. E. Gould