


T.16S.R.5W.W.M.

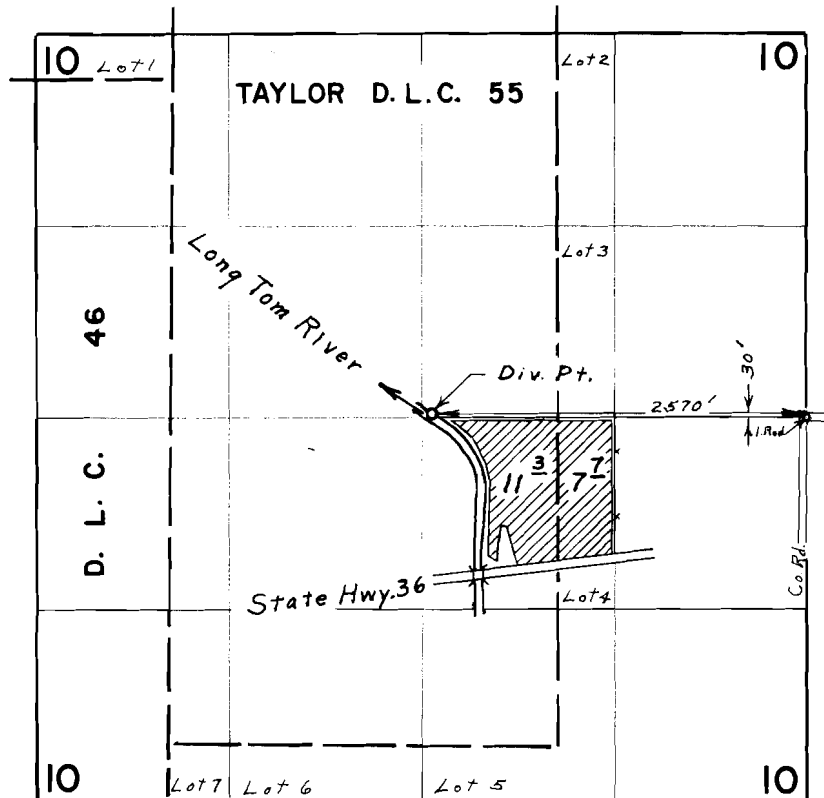

FINAL PROOF SURVEY
UNDER

Application No. 45194 Permit No. 33764
IN NAME OF

JOHN R. McARTHUR

Surveyed April 21, 1969, by L. E. Gould