


T.I.S.R.4W.W.M.

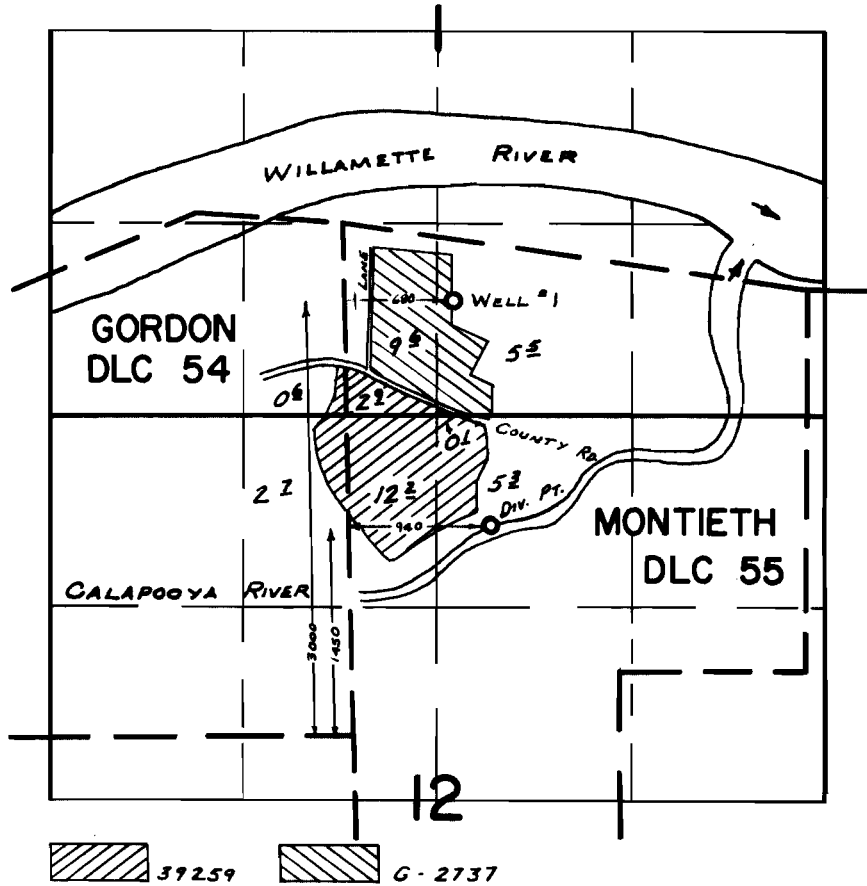

FINAL PROOF SURVEY UNDER

Application No. ~~39259~~ ^{G-2737} Permit No. ~~29242~~ ^{G-2537}
IN NAME OF

FLOYD M. & DOROTHY F. HOPEMAN

Surveyed May 19, 1969, by W. RUPPERT