


# T.10S.R.38&4W.W.M.

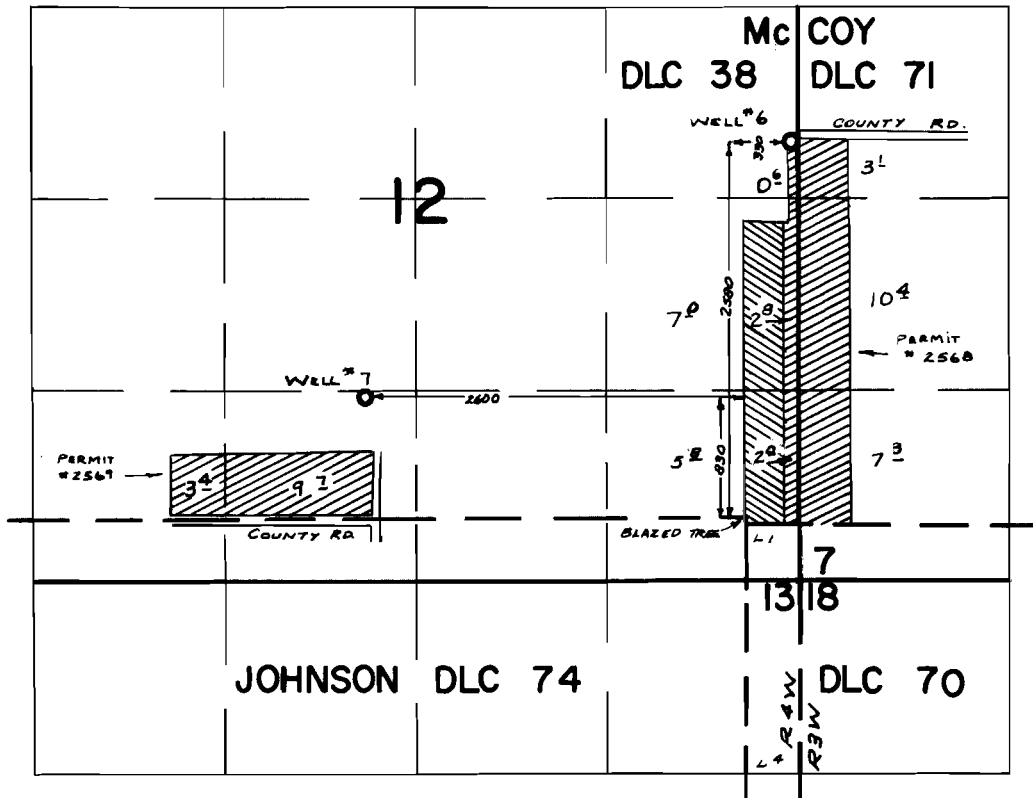

 SUPP.

## FINAL PROOF SURVEY UNDER

Application No. G-2765 Permit No. G-2568  
G-2746 G-2569  
 IN NAME OF

GORDON & HAZEL HOEFER

Surveyed MAR. 20, 1969, by W. RUPPERT