


# T.10S.R.38&4W.W.M.

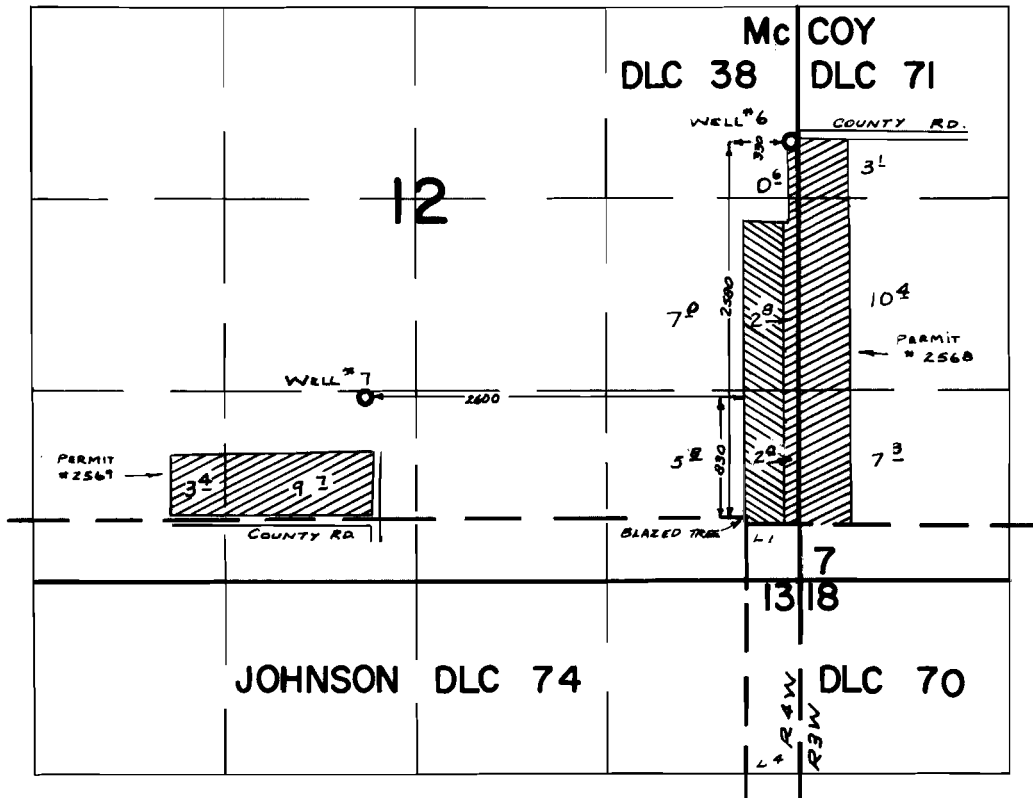

 SUPP.

## FINAL PROOF SURVEY UNDER

Application No. *G-2765* Permit No. *G-2568*  
*G-2746* *G-2569*  
 IN NAME OF

**GORDON & HAZEL HOEFER**

Surveyed *MAR. 20, 1969*, by *W. RUPPERT*