


T.9S.R.IW.W.M.

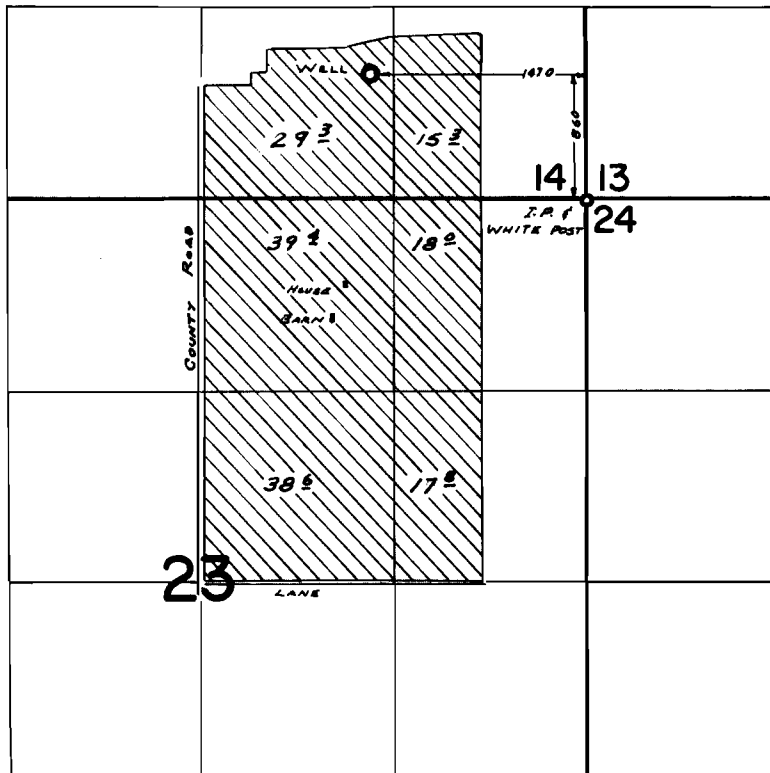

FINAL PROOF SURVEY UNDER

Application No. ~~G-2044~~ Permit No. ~~G-2639~~
IN NAME OF

JOHN FERY

Surveyed APR. 3, 1969, by W. RUPPERT