


T.9 S.R.1 W.W.M.

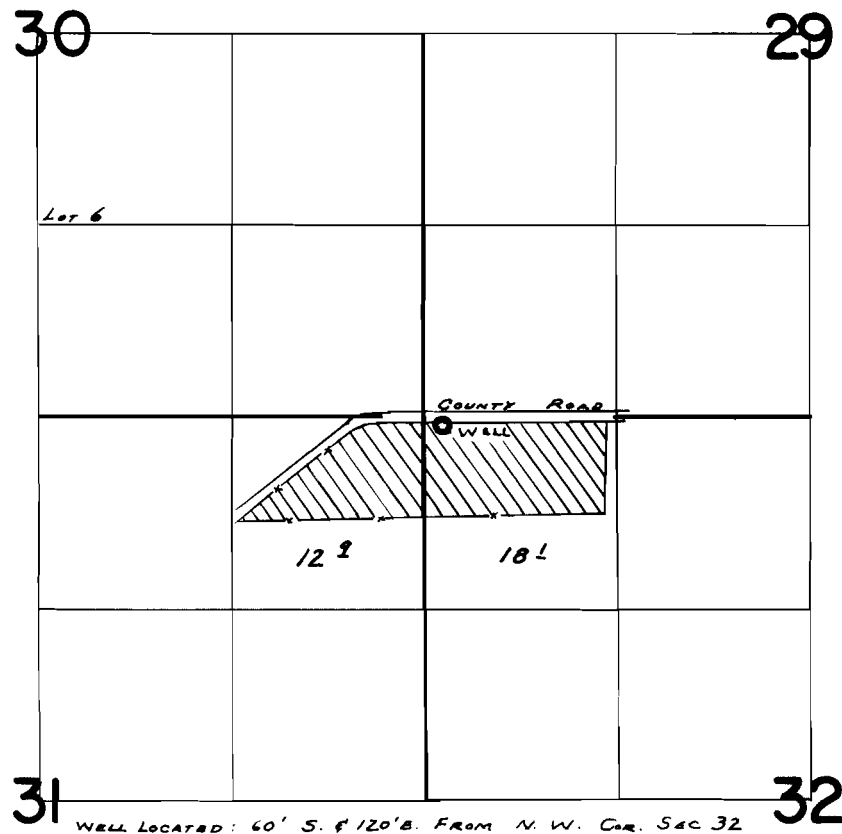

FINAL PROOF SURVEY UNDER

Application No. G-3052 Permit No. G-2848
IN NAME OF

JOSEPH J. & MAXINE J. SLANGAL

Surveyed APR. 8, 1969, by W. RUPPERT