


T.11S.R.2W.W.M.

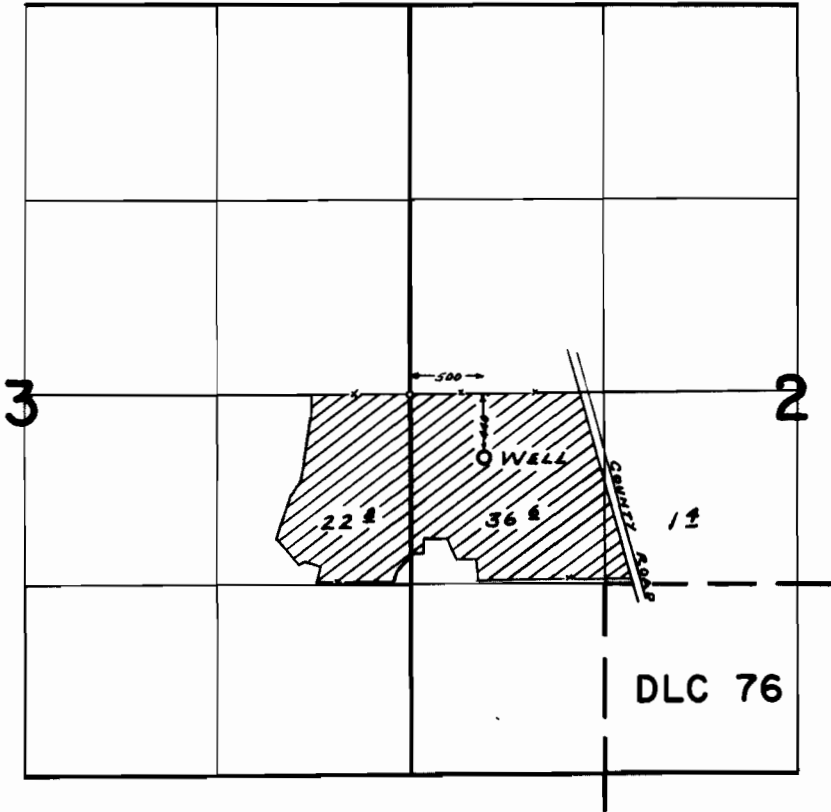

**FINAL PROOF SURVEY**  
UNDER

Application No. *G-3094* Permit No. *G-2890*  
IN NAME OF

**R. F. KLEINSCHMIT**

Surveyed *MAY 27, 1969*, by *W. RUPPERT*