


T.10 S.R.3 & 4 W.W.M.:

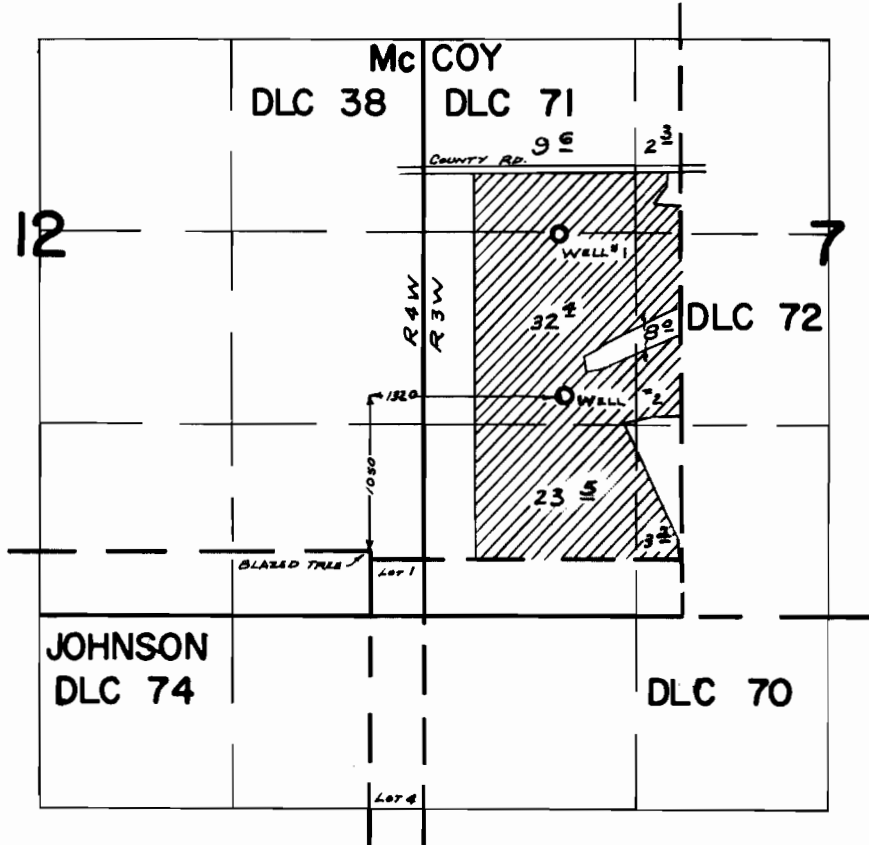

FINAL PROOF SURVEY UNDER

Application No. *G-3202* Permit No. *G-3023*
IN NAME OF

BERTHA L. BARNES

Surveyed *MARCH 21, 1969*, by *W. RUPPERT*