


T.11S.R.2W.W.M.

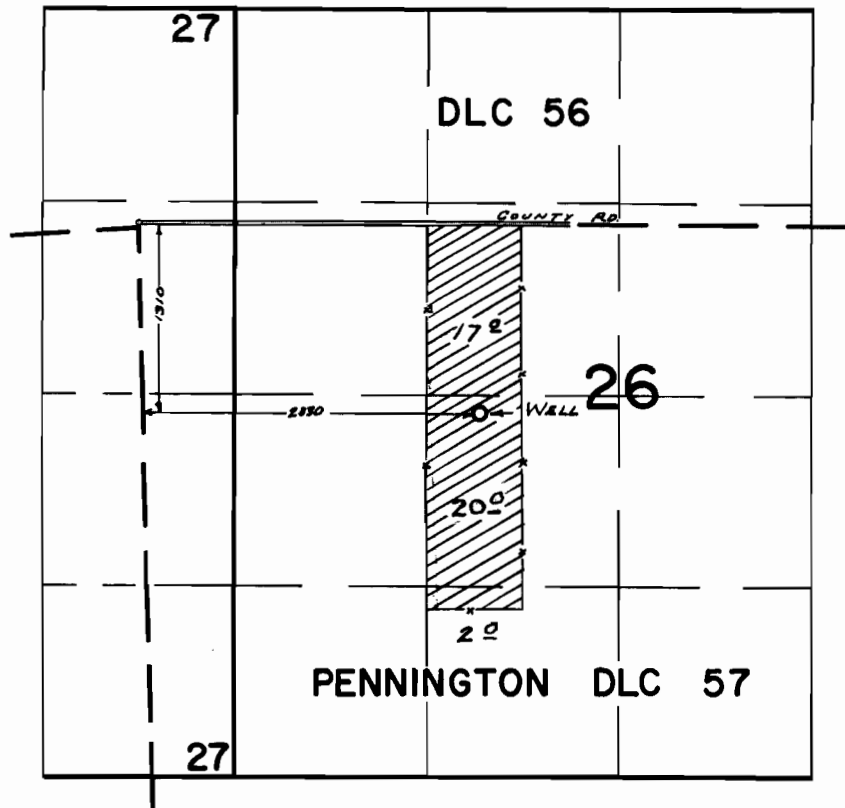

FINAL PROOF SURVEY
UNDER

Application No. G-3219 Permit No. G-3030
IN NAME OF

FRED J. & NADINE LUSCHER

Surveyed MAY 29, 1969, by W. RUPPERT