


T.9S.R.IW.W.M

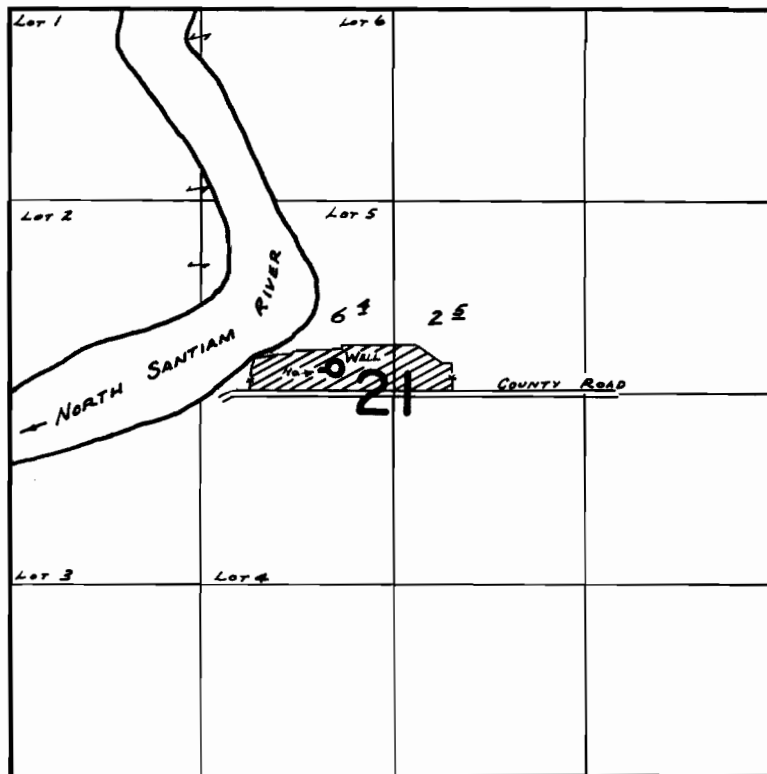

WELL LOCATED: 180' N. & 400' W. FROM CENTER SEC. 21

**FINAL PROOF SURVEY**  
UNDER

Application No. G-3432 Permit No. G-3100  
IN NAME OF

ROBERT J. O'CONNOR

Surveyed APR. 8, 1969, by W. RUPPERT