


T. 11S. R. 2W. W.M.

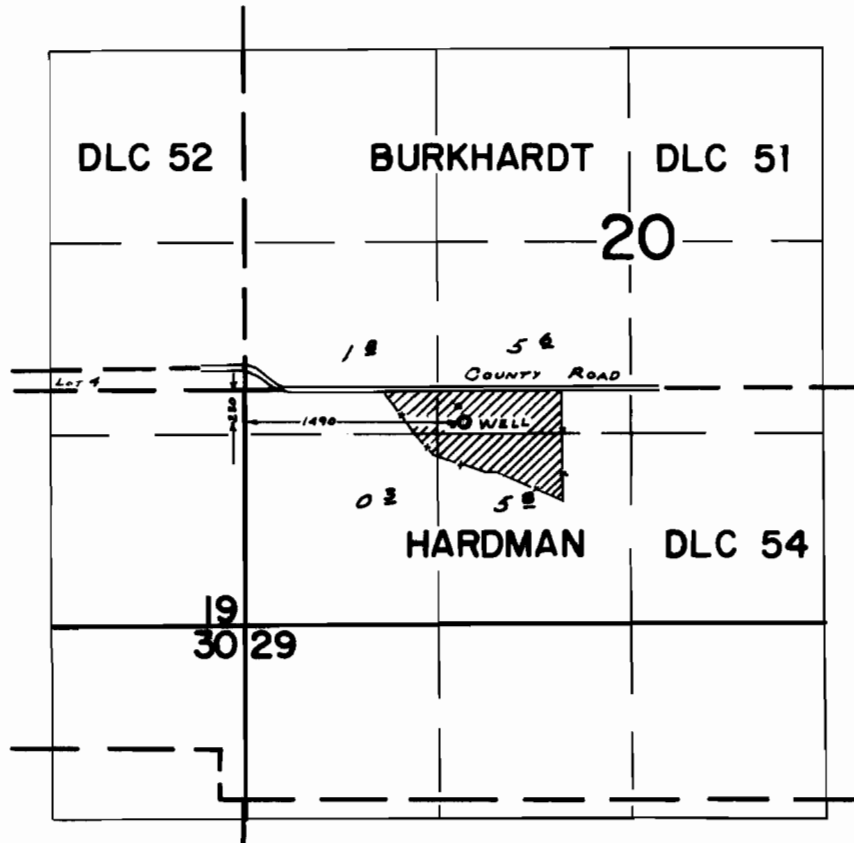

FINAL PROOF SURVEY UNDER

Application No. *G-3740* Permit No. *G-3469*
IN NAME OF

WILLSON C. & MAXINE E. RICH

Surveyed *JUNE 17 1969*, by *W. RUPPERT*