


T.10&11S.R.3W.W.M.

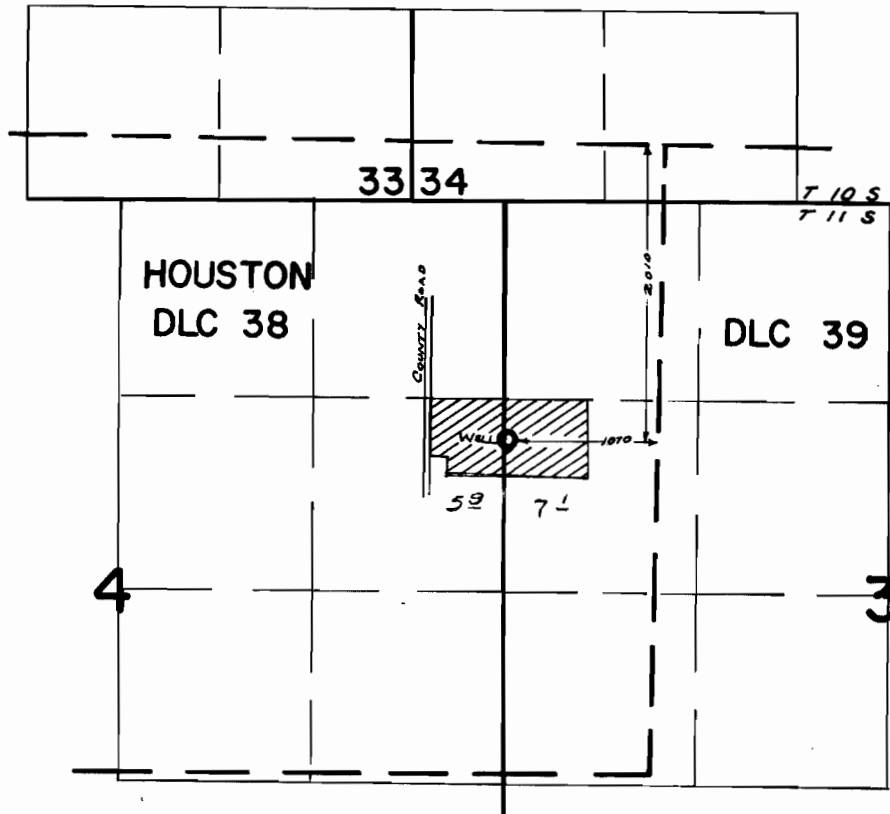

FINAL PROOF SURVEY UNDER

Application No. 6-4036 Permit No. 6-3716
IN NAME OF

CHARLES E. KARNOSH

Surveyed JULY 3, 1969, by W. RUPPERT