


T.11S.R.2W.W.M.

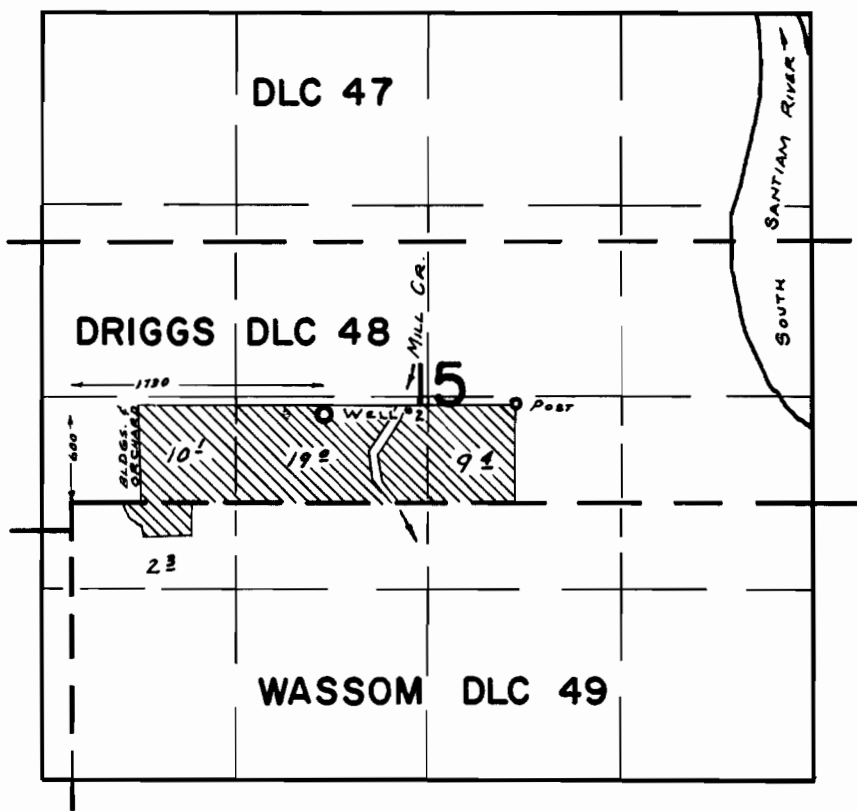

FINAL PROOF SURVEY
UNDER

Application No. *G-4042* Permit No. *G-3789*
IN NAME OF

ELMER L. & JENNIE R. PERRY

Surveyed *APR. 11, 1969*, by *W. RUPPERT*