


T.14S.R.IE.W.M.

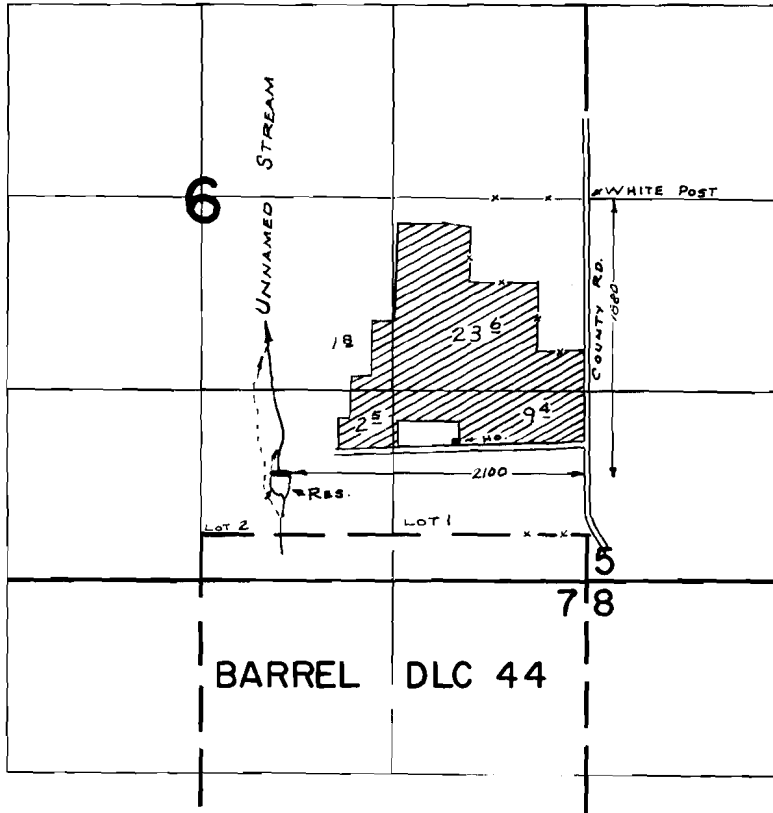

FINAL PROOF SURVEY
UNDER

Application No. R-39087 Permit No. R-4546
38854 30257
IN NAME OF _____

BILLY JOE & EVELYN FAE BROWN

Surveyed MAY 6, 1969, by W. RUPPERT