


T.14S.R.1E.W.M.

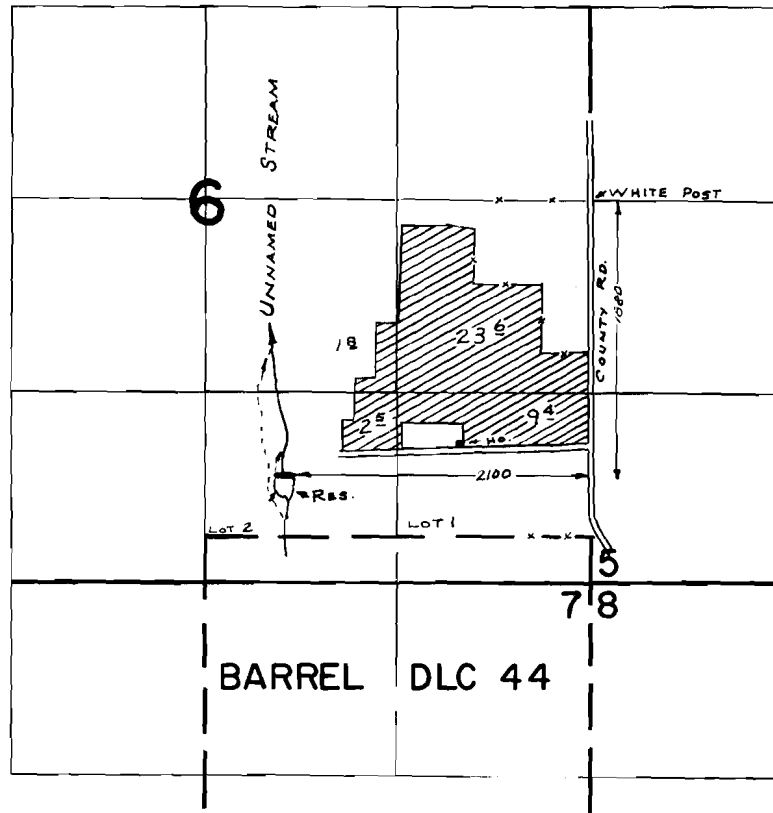

FINAL PROOF SURVEY
UNDER

Application No. ^{R-39087} 38854 Permit No. ^{R-4546} 30257
IN NAME OF

BILLY JOE & EVELYN FAE BROWN

Surveyed MAY 6, 1969, by W. RUPPERT