


# T. 13S. R. 1E. W. 4M.

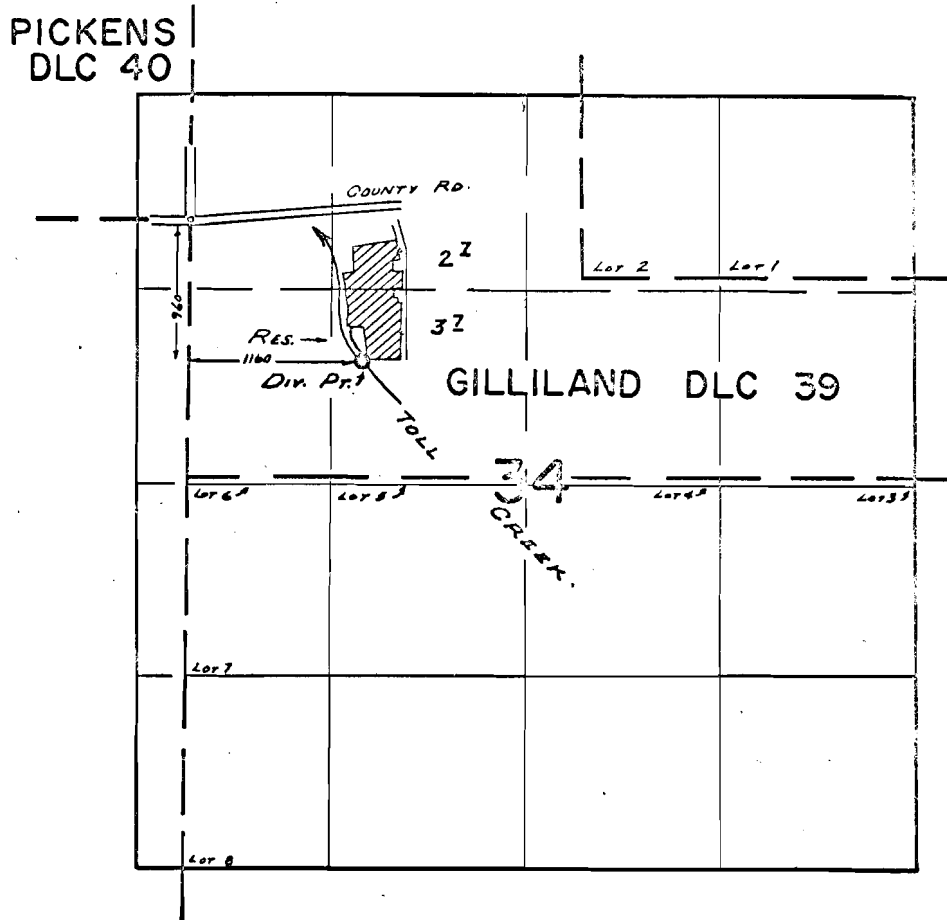

## FINAL PROOF SURVEY UNDER

R-42430                      R-4823  
Application No. 42431    Permit No. 31749  
IN NAME OF

JOSEPH E. & BETTE L. SCHLABACH

Surveyed APR. 23, 1969, by W. RUPPERT.