


# T.9S.R.IW.W.M.

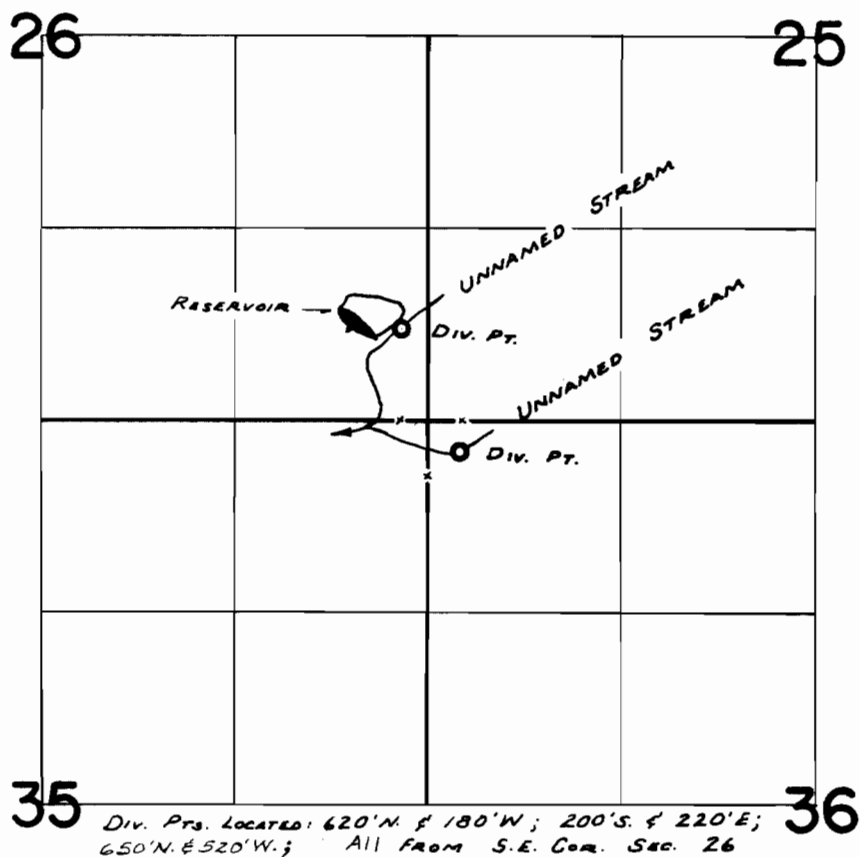

## FINAL PROOF SURVEY UNDER

R-44383 R-5142  
Application No. ~~44384~~ Permit No. 33153  
IN NAME OF

PAUL DOZLER

Surveyed APR. 3, 1969, by W. RUPPERT