


T.9S.R.IW.W.M.

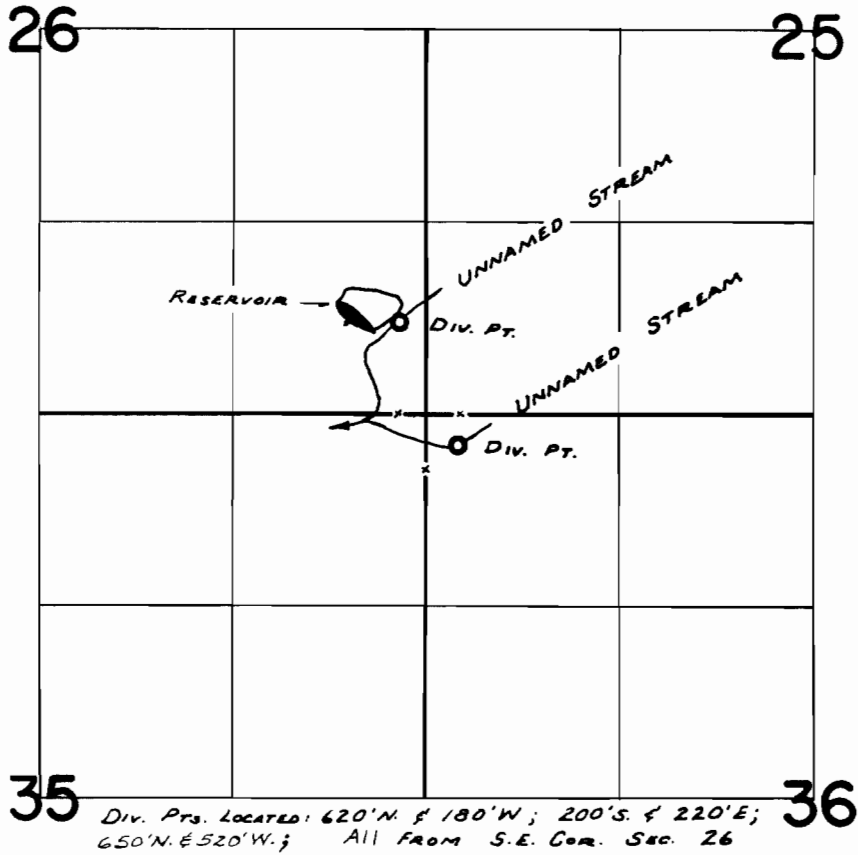

FINAL PROOF SURVEY UNDER

R-44383 R-5142
Application No. 44384 Permit No. 33153
IN NAME OF

PAUL DOZLER

Surveyed APR. 3, 1969, by W. RUPPERT