


# T.13S.R.1E.W.M.

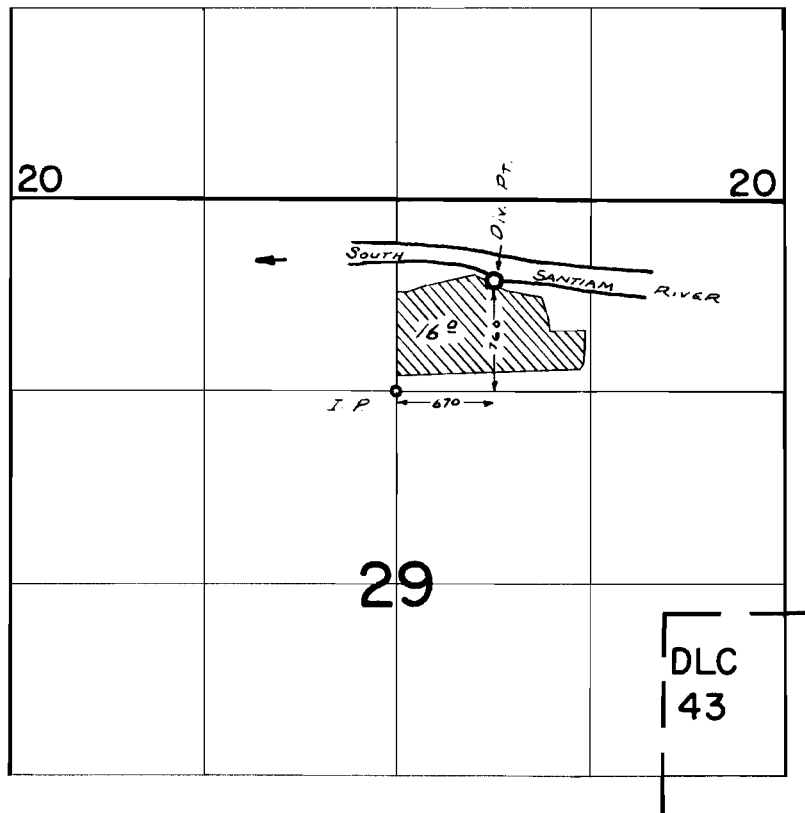

## FINAL PROOF SURVEY UNDER

Application No. 37581 Permit No. 27998  
IN NAME OF

**GLENN H. & Laverne PAYNE**

Surveyed APR. 21, 1969, by W. RUPPERT